

State of Kansas  
CARD MUST BE TYPED CORRECTED NOTICE OF INTENTION TO DRILL  
(see rules on reverse side)

Corrected  
CARD MUST BE SIGNED  
10-18-84

Starting Date: October 20 1984  
month day year

API Number 15- 151,21,495 - 00-20

OPERATOR: License # 5056  
Name F. G. Holl  
Address 6427 East Kellogg  
City/State/Zip Wichita, KS 67207  
Contact Person W. J. Monk  
Phone (316) 684-8481

X C. SE. NW. Sec. 29: Twp. 29. S, Rge. 12  East  West  
(location)  
X 3300 Ft North from Southeast Corner of Section  
X 3300 Ft West from Southeast Corner of Section  
(Note: Locate well on Section Plat on reverse side)

CONTRACTOR: License # 5142  
Name Sterling Drilling Co.  
City/State Sterling, Kansas 67579

Nearest lease or unit boundary line 660 feet.  
County PRATT  
Lease Name HIRT Well# 2-29

Well Drilled For: Well Class: Type Equipment:  
 Oil  Swd  Infield  Mud Rotary  
 Gas  Inj  Pool Ext.  Air Rotary  
 OWWO  Expl  Wildcat  Cable

Domestic well within 330 feet:  yes  no  
Municipal well within one mile:  yes  no

If OWWO: old well info as follows:  
Operator .....  
Well Name .....  
Comp Date ..... Old Total Depth .....  
Projected Total Depth 4750 feet  
Projected Formation at TD Arbuckle  
Expected Producing Formations Viola

Depth to Bottom of fresh water 196 feet  
Lowest usable water formation Harper Siltstone  
Depth to Bottom of usable water ..... feet  
Surface pipe by Alternate: 1  2   
Surface pipe to be set 240 feet  
Conductor pipe if any required ..... feet  
Ground surface elevation 1895 est. feet MSL  
This Authorization Expires 4-10-85  
Approved By 10-10-84

I certify that we will comply with K.S.A. 55-101, et seq., plus eventually plugging hole to K.C.C. specifications.

Date Oct. 18, 1984  
Signature of Operator or Agent W. J. Monk

was: NW SE NW  
3630 FSL  
Geologist 3630 FEL


Corrected to show different location

RECEIVED  
STATE CORPORATION COMMISSION

Must be filed with the K.C.C. five (5) days prior to commencing well  
drilling. If drilling not started within six (6) months of date received by K.C.C.

OCT 18 1984

CONSERVATION DIVISION  
Wichita, Kansas  
A Regular Section of Land  
1 Mile = 5,280 Ft.

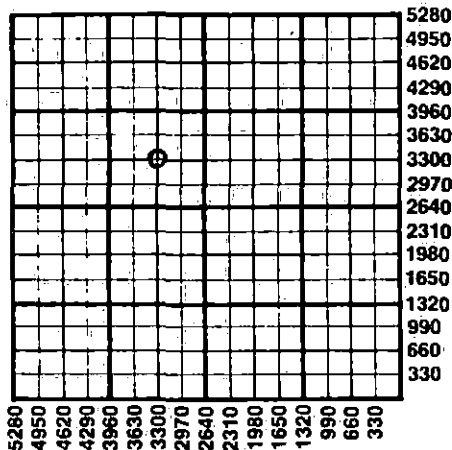

**Important procedures to follow :**

1. Notify District office before setting surface casing.
2. Set surface casing by circulating cement to the top.
3. File completion forms ACO-1 with K.C.C. within 90 days of well completion, following instructions on ACO-1, side 1, and including copies of wireline logs.
4. Notify District office 48 hours prior to old well workover or re-entry.
5. Prior to plugging, prepare a plugging plan, then obtain agreement from the appropriate district office for an approved plugging plan.
6. Submit plugging report (CP-4) to K.C.C. after plugging is completed.
7. Obtain an approved injection docket number before disposing of salt water.
8. Notify K.C.C. within 10 days when injection commences or terminates.
9. If an alternate 2 completion, cement in the production pipe from below any usable water to surface within 120 days of spud date.

State Corporation Commission of Kansas  
Conservation Division  
200 Colorado Derby Building  
Wichita, Kansas 67202  
(316) 263-3238