

CARD MUST BE TYPED

State of Kansas

CARD MUST BE SIGNED

NOTICE OF INTENTION TO DRILL

(see rules on reverse side)

VDA

Expected Spud Date... 7 month 2 day 88 year

API Number 15-151-21,892-00-00

OPERATOR: License # 3536

C NE SW SE Sec. 36 Twp. 28S S, Rg. 14W East West

Name Ramco Drilling Services, Inc.

Address P.O. Box 99

City/State/Zip Belpre, Ohio 45714

Contact Person Mr. David Gocke

Phone 614-423-9591

CONTRACTOR: License # 5302

Name Red Tiger Drilling Co.

City/State Wichita, Kansas 67202

990 Ft. from South Line of Section

1650 Ft. from East Line of Section

(Note: Locate well on Section Plat on reverse side)

Nearest lease or unit boundary line 330 feet

County Pratt

Lease Name Allen Neidhardt Well # 1

Ground surface elevation 1986 feet MSL

Domestic well within 330 feet: yes no

Municipal well within one mile: yes no

Depth to bottom of fresh water 240

Depth to bottom of usable water 240

Surface pipe by Alternate: 1 X 2

Surface pipe planned to be set 400'

Conductor pipe required N/A

Projected Total Depth 4600 feet

Well Drilled For: Well Class: Type Equipment:

X Oil Storage Infield Mud Rotary

Gas Inj Pool Ext Air Rotary

OWWO Expl Wildcat Cable

If OWWO: old well info as follows:

Operator

Well Name

Comp Date Old Total Depth

I certify that well will comply with K.S.A. 55-101, et seq., plus every fully plugging hole KCC specifications.

Date 6-27-88 Signature of Operator or Agent

Title Owner

BY RED TIGER DRILLING COMPANY

For KCC Use:

Conductor Pipe Required feet; Minimum Surface Pipe Required 260 feet per Alt 1

This Authorization Expires 12-27-88 Approved By RCH 6-27-88

OX


EFFECTIVE DATE: 7-2-88

Must be filed with the K.C.C. five (5) days prior to commencing well
This card void if drilling not started within six (6) months of date received by K.C.C.

Important procedures to follow:

1. Notify District office before setting surface casing.
2. Set surface casing by circulating cement to the top.
3. File completion forms ACO-1 with K.C.C. within 120 days of well spud date, following instructions on ACO-1, side 1, and including copies of wireline logs.
4. Notify District office 48 hours prior to old well workover or re-entry.
5. Prior to filing Intent, prepare a proposed plugging plan in case well is D & A, then obtain approval of plan when calling district office prior to setting surface pipe.
6. Submit plugging report (CP-4) to K.C.C. after plugging is completed.
7. Obtain an approved injection docket number before disposing of salt water.

A Regular Section of Land
1 Mile = 5,280 Ft.

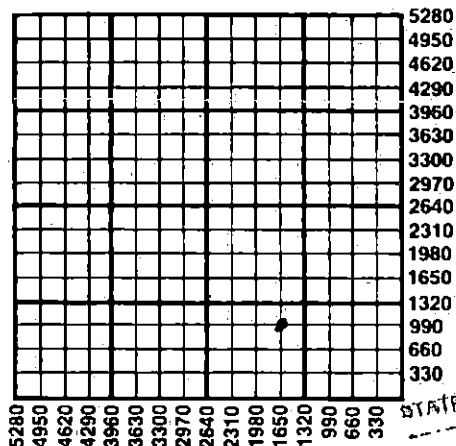

RECEIVED
STATE CORPORATION COMMISSIONS.
Notify K.C.C. within 10 days when injection commences or terminates.

JUN 27 1988
6-27-88
CONSERVATION DIVISION
Wichita, Kansas

an alternate 2 completion, cement in the production pipe from below any usable water to surface within 120 days of spud date.

State Corporation Commission of Kansas
Conservation Division
200 Colorado Derby Building
Wichita, Kansas 67202-1212
(316) 263-3238