

CARD MUST BE TYPED

State of Kansas

CARD MUST BE SIGNED

NOTICE OF INTENTION TO DRILL

(see rules on reverse side)

2nd CORRECTION

E-L 7851  
\* 145,390-C (C-29973)

Starting Date 12 6 1985  
month day year

API Number 15-151-21,706-00-00 12-9-85  
15

OPERATOR: License # 9069 app.

NE NE SE Sec. 1 Twp. 28 S, Rg. 14 East  
X West

Name General Oil Company

Address 110 S. Main, Suite 402

City/State/Zip Wichita, KS 67202

Contact Person John Bannister

Phone 316-263-8588

\* 2130 Ft. from South Line of Section

470 Ft. from East Line of Section

(Note: Locate well on Section Plat on reverse side)

CONTRACTOR: License # 5418

Name Allen Drilling

City/State Great Bend, KS 67530

\* Nearest lease or unit boundary line 90 feet

County Pratt

Lease Name City of Cullison Well # 1

Ground surface elevation feet MSL

Well Drilled For: Well Class: Type Equipment:

X Oil SWD X Infield X Mud Rotary  
Gas Inj Pool Ext Air Rotary  
OWWO Expl Wildcat Cable

Domestic well within 330 feet: yes X no

Municipal well within one mile: yes X no

Surface pipe by Alternate: 1 2 X 3

Depth to bottom of fresh water 70

Depth to bottom of usable water 200

Surface pipe planned to be set 250

Projected Total Depth 4400 feet

Formation Mississippi

If OWWO: old well info as follows:

Operator

Well Name

Comp Date Old Total Depth

I certify that well will comply with K.S.A. 55-101, et seq., plus eventually plugging hole to KCC specifications.

2310 FSL

cementing will be done immediately upon setting production casing.

\* was 330' Nearest lease line

Date 12/6/85 Signature of Operator or Agent Elaine Parkman Title as agent

For KCC Use:

Conductor Pipe Required feet; Minimum Surface Pipe Required feet per Alt. 1 2


This Authorization Expires 3-13-86 Approved By 9-13-85

Must be filed with the K.C.C. five (5) days prior to commencing well  
This card void if drilling not started within six (6) months of date received by K.C.C.

**Important procedures to follow:**

1. Notify District office before setting surface casing.
2. Set surface casing by circulating cement to the top.
3. File completion forms ACO-1 with K.C.C. within 90 days of well completion, following instructions on ACO-1, side 1, and including copies of wireline logs.
4. Notify District office 48 hours prior to old well workover or re-entry.
5. Prior to filing Intent, prepare a proposed plugging plan in case well is D & A, then obtain approval of plan when calling district office prior to setting surface pipe.
6. Submit plugging report (CP-4) to K.C.C. after plugging is completed.
7. Obtain an approved injection docket number before disposing of salt water.
8. Notify K.C.C. within 10 days when injection commences or terminates.
9. If an alternate 2 completion, cement in the production pipe from below any usable water to surface within 120 days of spud date.

**A Regular Section of Land**  
**1 Mile = 5,280 Ft.**

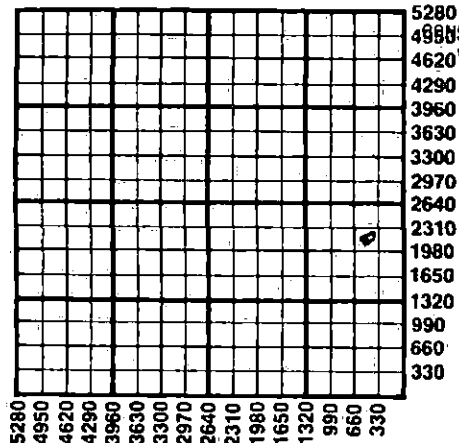

RECEIVED  
STATE CORPORATION COMMISSION  
12-6-85  
DEC 06 1985

CONSERVATION DIVISION

State Corporation Commission of Kansas  
Conservation Division  
200 Colorado Derby Building  
Wichita, Kansas 67202  
(316) 263-3238