

STATE OF KANSAS  
STATE CORPORATION COMMISSION

Form CP-4


Give All Information Completely  
Make Required Affidavit  
Mail or Deliver Report to:  
Conservation Division  
State Corporation Commission  
212 No. Market  
Wichita, Kansas

WELL PLUGGING RECORD

Pratt County, Sec. 22 Twp. 29S Rge. 12W (E) (W)

Location as "NE/CNW/SW" or footage from lines C NE NW  
Lease Owner Comet Petroleum Corporation  
Lease Name J. Brubaker Well No. 1  
Office Address Suite 500, 250 West Douglas, Wichita, Kansas  
Character of Well (completed as Oil, Gas or Dry Hole) Dry Hole  
Date well completed January 20 19 70  
Application for plugging filed January 20 19 70  
Application for plugging approved January 20 19 70  
Plugging commenced January 20 19 70  
Plugging completed January 21 19 70  
Reason for abandonment of well or producing formation \_\_\_\_\_

NORTH

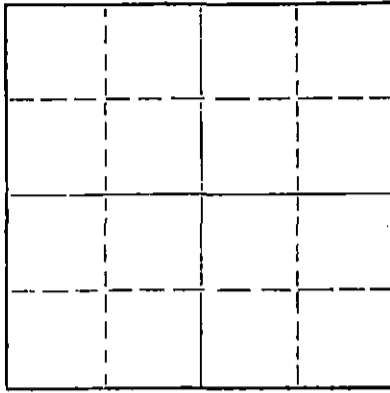

Locate well correctly on above  
Section Plat

If a producing well is abandoned, date of last production \_\_\_\_\_ 19\_\_\_\_  
Was permission obtained from the Conservation Division or its agents before plugging was commenced? yes

Name of Conservation Agent who supervised plugging of this well Russell Biberstein  
Producing formation \_\_\_\_\_ Depth to top \_\_\_\_\_ Bottom \_\_\_\_\_ Total Depth of Well 4623 Feet  
Show depth and thickness of all water, oil and gas formations.

OIL, GAS OR WATER RECORDS

CASING RECORD

FORMATION	CONTENT	FROM	TO	SIZE	PUT IN	PULLED OUT
				10-3/4"	248'	-

Describe in detail the manner in which the well was plugged, indicating where the mud fluid was placed and the method or methods used in introducing it into the hole. If cement or other plugs were used, state the character of same and depth placed, from \_\_\_\_\_ feet to \_\_\_\_\_ feet for each plug set.

Mud to 240', 1/2 sack hulls, plug, 30 sacks cement  
Mud to 40', 1/2 sack hulls, plug, 15 sacks cement  
2 sacks cement in rathole

(If additional description is necessary, use BACK of this sheet)

Name of Plugging Contractor \_\_\_\_\_  
Address \_\_\_\_\_

STATE OF KANSAS, COUNTY OF SEDGWICK, ss.  
Don Gardner

(employee of owner) or (XXXXXXX) of the above-described well, being first duly sworn on oath, says: That I have knowledge of the facts, statements, and matters herein contained and the log of the above-described well as filed and that the same are true and correct. So help me God.

(Signature) \_\_\_\_\_  
Suite 250, 200 West Douglas, Wichita, Kansas  
(Address)

SUBSCRIBED AND SWORN to before me this 21st day of January, 19 70

My commission expires December 14, 1973

\_\_\_\_\_  
Notary Public.

