


WELL PLUGGING RECORD

Give All Information Completely
Make Required Affidavit
Mail or Deliver Report to:
Conservation Division
State Corporation Commission
211 No. Broadway
Wichita, Kansas

NORTH

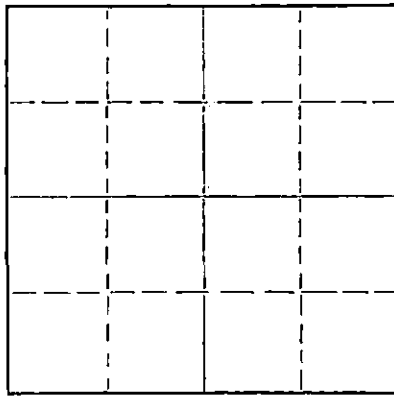

Locate well correctly on above
Section Plat

Prett County. 36 Twp 28S Rge. (E) 14 (W)
Location as "NE/CNW/SW" or footage from lines 2319' from W & 331' from South
Lease Owner Phillips Petroleum Company
Lease Name Tena Well No. 1
Office Address Box 779, Great Bend, Kansas
Character of Well (completed as Oil, Gas or Dry Hole) Oil
Date well completed September 24, 19 54
Application for plugging filed November 19, 19 57
Application for plugging approved November 21, 19 57
Plugging commenced November 27, 19 57
Plugging completed December 5, 19 57
Reason for abandonment of well or producing formation Uneconomical to operate.

If a producing well is abandoned, date of last production 9-18-57 19
Was permission obtained from the Conservation Division or its agents before plugging was commenced? Yes

Name of Conservation Agent who supervised plugging of this well Mr. M. A. Rives
Producing formation Simpson Sand Depth to top 4516 Bottom NR Total Depth of Well PH4468 Feet
Show depth and thickness of all water, oil and gas formations. OTD 4655

OIL, GAS OR WATER RECORDS

CASING RECORD

FORMATION	CONTENT	FROM	TO	SIZE	PUT IN	PULLED OUT
Douglas	Dry	3819	3960	10-3/4"	357.03	None
Brown Limestone	Dry	3960	3979	7"	4683.50	3138'
Lansing-Kansas City	Dry	3979	4339			
Mississippian	Dry	4443	4480			
Viola	Dry	4480	4510			
Simpson Shale	Dry	4510	4516			
Simpson Sand	Oil	4516	4620			
Arbuckle	Dry	4620	4655			

Describe in detail the manner in which the well was plugged, indicating where the mud fluid was placed and the method or methods used in introducing it into the hole. If cement or other plugs were used, state the character of same and depth placed, from _____ feet to _____ feet for each plug set.

Well was plugged back from OTD 4655 to PSTD 4468 on prior workover jobs.

Set rock bridge 4468' to 4430'. Dumped 6 sx. cement to 4385'. Mudded hole 4385' to 300'. Set rock bridge 300' to 290'. Spotted 25 sx. cement 290' to 240'. Mudded hole 240' to 40'. Set rock bridge 40' to 30'. Dumped 15 sx. cement in filling to base of cellar. Well plugged and abandoned 10:00 A.M. 12-5-57.

RECORDED
STATE CORPORATION COMMISSION
12-7-57
DEC 7 1957
CONSERVATION DIVISION
Wichita, Kansas

(If additional description is necessary, use BACK of this sheet)

Name of Plugging Contractor West Supply Company
Address Chase, Kansas

STATE OF Kansas, COUNTY OF Barton, ss.
A. J. Willis (employee of owner) ~~not a sworn operator~~ of the above-described well, being first duly sworn on oath, says: That I have knowledge of the facts, statements, and matters herein contained and the log of the above-described well as filed and that the same are true and correct. So help me God.

(Signature) A. J. Willis
Box 779, Great Bend, Kansas
(Address)

SUBSCRIBED AND SWORN TO before me this 6th day of December, 19 57

My commission expires 11-18-61

Joseph M. Real
Notary Public.

PLUGGING
FILE SEC. 36 T. 28 R. 14W
BOOK PAGE 62 LINE 37

Phillips Petroleum Company

EXPLORATION RECORD

Tena #1 - 2319' from West line and 331' from South line, Section 36-28S-14W,
Pratt County, Kansas.

Lease Tena

Well 1

Formation Name	Top	Base	Remarks
Sand and redbed	0	320	
Shale	320	365	
Shale and shells	365	662	
Redbed and shells	662	1046	
Shale and shells	1046	2044	
Lime and shale	2044	2164	
Shale	2164	2249	
Lime and shale	2249	2547	
Shale	2547	2666	
Lime and shale	2666	3323	
Lime	3323	3384	
Lime and shale	3384	3537	
Lime	3537	3846	
Lime and shale	3846	3988	
Lime	3988	4411	
Lime and chert	4411	4442	
Lime	4442	4463	
Lime and chert	4463	4530	
Sand and shale	4530	4619	
Dolomite	4619	4629	
Lime	4629	4655	
 <u>FORMATION TOPS:</u>			
Heebner	3781		
Toronto	3800		
Douglas	3819		
Brown Limestone	3960		
Lansing-Kansas City	3979		
Drum	4142		
Base-Kansas City	4339		
Mississippian	4443		
Viola	4480		
Simpson Shale	4510		
Simpson Sandstone	4516		
Arbuckle	4620		
Rotary Total Depth	4655		

REGISTRATION
STATE OF KANSAS
JUL 7 1910
GEOLOGICAL DIVISION
Wichita, Kansas

PLUGGING
FILE SEC. 36 T. 28 R. 14W
BOOK PAGE 62 LINE 37