


STATE OF KANSAS  
STATE CORPORATION COMMISSION

WELL PLUGGING RECORD

Give All Information Completely  
Make Required Affidavit  
Mail or Deliver Report to  
Conservation Division  
State Corporation Comm.  
245 North Water  
Wichita, KS 67202

Haskell County. Sec. 33 Twp. 29 Rge. 34 E/W  
Location as "NE/CNW 1/4 SW 1/4" or footage from lines

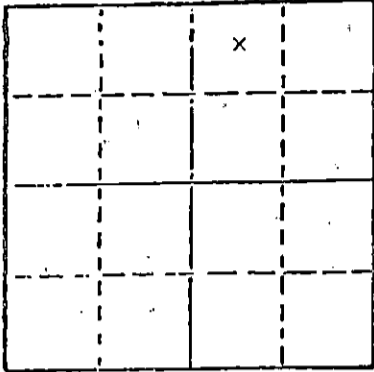

NW NE 1/4  
Lease Owner Ashland Oil Co.  
Lease Name Kirkpatrick Well No. 5  
Office Address Box 127, Satanta, Kansas 67870  
Character of Well (Completed as Oil, Gas or Dry Hole)

Oil  
Date Well completed 3-27-1961  
Application for plugging filed 5-22-1978  
Application for plugging approved 5-23-1978  
Plugging commenced 7-12-1978  
Plugging completed 7-14-1978

Reason for abandonment of well or producing formation  
Non Commercial Value  
If a producing well is abandoned, date of last production 19

Was permission obtained from the Conservation Division or its agents before plugging was commenced? Yes

Name of Conservation Agent who supervised plugging of this well Mr. Thomas  
Producing formation Chester Depth to top 5418' Bottom 5441' Total Depth of Well 5530'  
Show depth and thickness of all water, oil and gas formations.

OIL, GAS OR WATER RECORDS

CASING RECORD

FORMATION	CONTENT	FROM	TO	SIZE	PUT IN	PULLED OUT
Surface				8 5/8"	1823'	0'
Production				5 1/2"	5487'	2052'

Describe in detail the manner in which the well was plugged, indicating where the mud fluid was placed and the method or methods used in introducing it into the hold. If cement or other plugs were used, state the character of same and depth placed, from feet to feet for each plug set.

Pumped 4 sacks Hulla & 30 sacks cement to 3850' Pressured to 1000 lbs.  
Displaced to 1800'  
Pumped 30 sacks cement 1800' to 1700'  
Displaced to 40'  
Put bridge & 10 sacks cement 40' to 0'

RECEIVED  
STATE CORPORATION COMMISSION

JUL 18 1978

7-18-1978

CONSERVATION DIV.  
Wichita, Kansas

(If additional description is necessary, use BACK of this sheet)

Name of Plugging Contractor Midwest Casing Pulling  
Box F, Sublette, Kansas 67877 Permit #766

STATE OF KANSAS COUNTY OF Haskell, ss.

I Edgar J. Evas (employee of owner) or (owner or operator) of the above-described well, being first duly sworn on oath, says: That I have knowledge of the facts, statements, and matters herein contained and the log of the above-described well as filed and that the same are true and correct. So help me God.

(Signature)

Edgar J. Evas  
Box F, Sublette, Kansas 67877  
(Address)

SUBSCRIBED AND SWORN TO before me this 15th day of July, 1978

Sondra L. Eves

Notary Public.

My commission expires 12-6-80

