


STATE OF KANSAS
STATE CORPORATION COMMISSION

Give All Information Completely
Make Required Affidavit
Mail or Deliver Report to:
Conservation Division
State Corporation Commission
800 Bitting Building
Wichita, Kansas

WELL PLUGGING RECORD

NORTH

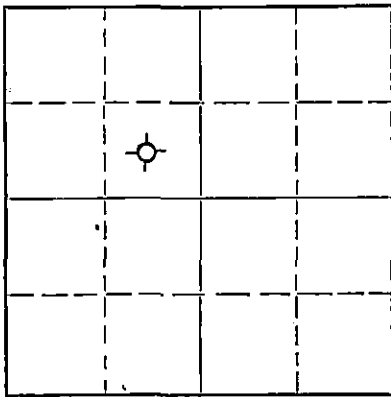

Locate well correctly on above
Section Plat

Haskell County, Sec. 33 Twp. 29S. Rge. 34W (E) (W)
Location as "NE/CNW/SW" or footage from lines SE-NW
Lease Owner United Producing Company, Inc.
Lease Name J. L. Kirkpatrick Well No. 6
Office Address Drawer 30, Liberal, Kansas
Character of Well (completed as Oil, Gas or Dry Hole) Dry Hole
Date well completed Temporarily abandoned 5-23 19 61
Application for plugging filed December 17 19 61
Application for plugging approved January 3 19 62
Plugging commenced February 12 19 62
Plugging completed February 15 19 62
Reason for abandonment of well or producing formation Dry Hole

If a producing well is abandoned, date of last production None 19
Was permission obtained from the Conservation Division or its agents before plugging was commenced? Yes

Name of Conservation Agent who supervised plugging of this well Mr. W. L. LaKamp
Producing formation None Depth to top Bottom Total Depth of Well 5506 Feet
Show depth and thickness of all water, oil and gas formations.

OIL, GAS OR WATER RECORDS

CASING RECORD

FORMATION	CONTENT	FROM	TO	SIZE	PUT IN	PULLED OUT
				8 5/8	1832	None
				5 1/2	5460	2931

Describe in detail the manner in which the well was plugged, indicating where the mud fluid was placed and the method or methods used in introducing it into the hole. If cement or other plugs were used, state the character of same and depth placed, from feet to feet for each plug set.

Filled hole with heavy laden mud from 5506 to 3915, spotted 25 sx cement to 4000', filled with heavy laden mud to 685', spotted 25 sx cement to 600', filled with heavy laden mud, spotted 10 sx cement in top 8 5/8, welded cap on 8 5/8" after cutting off 4' below ground level.

RECEIVED
STATE CORPORATION COMMISSION
FEB 19 1962
CONSERVATION DIVISION
Wichita, Kansas
2-19-1962

(If additional description is necessary, use BACK of this sheet)

Name of Plugging Contractor Halliburton
Address Liberal, Kansas

STATE OF Kansas, COUNTY OF Seward, ss.
L. S. Brown (employee of owner) or (owner or operator) of the above-described well, being first duly sworn on oath, says: That I have knowledge of the facts, statements, and matters herein contained and the log of the above-described well as filed and that the same are true and correct. So help me God.

(Signature) L. S. Brown
Drawer 30, Liberal, Kansas (Address)

SUBSCRIBED AND SWORN TO before me this 16th day of February, 19 62

My commission expires April 8, 1964

Lila J. Brewer
Notary Public.