

STATE OF KANSAS  
STATE CORPORATION COMMISSION

WELL PLUGGING RECORD

Give All Information Completely  
Make Required Affidavit  
Mail or Deliver Report to:  
Conservation Division  
State Corporation Commission  
212 No. Market  
Wichita, Kansas

Pratt County, Sec. 2 Twp. 29S Rge. 13 (X) (W)

Location as "NE/CNW/SW" or footage from lines C SW SE

Lease Owner W. C. PAYNE

Lease Name Peachey Well No. 1

Office Address 800 United Founders Tower, Okla. City, Okla. 73112

Character of Well (completed as Oil, Gas or Dry Hole) Dry Hole

Date well completed 11-30 19 69

Application for plugging filed 11-30 19 69

Application for plugging approved 11-30 19 69


Plugging commenced 12-1 19 69

Plugging completed 12-1 19 69

Reason for abandonment of well or producing formation Dry hole

If a producing well is abandoned, date of last production 19

Was permission obtained from the Conservation Division or its agents before plugging was commenced? Yes

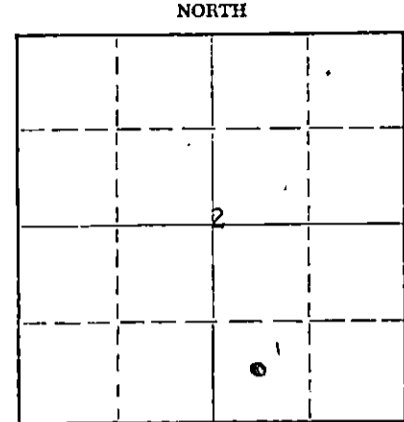

Locate well correctly on above Section Plat

Name of Conservation Agent who supervised plugging of this well Herman Justis

Producing formation None Depth to top Bottom Total Depth of Well 4778 Feet

Show depth and thickness of all water, oil and gas formations.

OIL, GAS OR WATER RECORDS

CASING RECORD

FORMATION	CONTENT	FROM	TO	SIZE	PUT IN	PULLED OUT
				10-3/4"	292'	None
				8-5/8"	1017'	853

Describe in detail the manner in which the well was plugged, indicating where the mud fluid was placed and the method or methods used in introducing it into the hole. If cement or other plugs were used, state the character of same and depth placed, from feet to feet for each plug set.

Shot off and pulled 853' of 8-5/8" surface casing. Filled hole with mud, ran drill pipe to 300' and Halliburton pumped 30 sack cement plug from 300' up to 240' inside 10-3/4" pipe. Load hole with mud, push wooden plug to 40' and pump 20 sack cement plug from 40' up to 3' inside 10-3/4" Pipe. Job complete @ 2:00 a. m. 12-1-69.

RECEIVED  
STATE CORPORATION COMMISSION  
DEC 3 1969  
CONSERVATION DIVISION  
Wichita, Kansas

(If additional description is necessary, use BACK of this sheet)  
Name of Plugging Contractor Thomas Drilling Company  
Address P. O. Box 400, Duncan, Oklahoma

STATE OF OKLAHOMA, COUNTY OF OKLAHOMA, ss.  
William F. Ashburn (employee of owner) of the above-described well, being first duly sworn on oath, says: That I have knowledge of the facts, statements, and matters herein contained and the log of the above-described well as filed and that the same are true and correct. So help me God.

(Signature) Wm. F. Ashburn  
800 United Founders Tower, Okla. City, Okla.  
(Address)

SUBSCRIBED AND SWORN TO before me this 2nd day of December, 19 69

My commission expires July 1, 1960

Paula J. Pitman  
Notary Public.