


STATE OF KANSAS
STATE CORPORATION COMMISSION
Give All Information Completely
Make Required Affidavit
Mail or Deliver Report to:
Conservation Division
State Corporation Commission
211 No. Broadway
Wichita, Kansas

WELL PLUGGING RECORD

NORTH

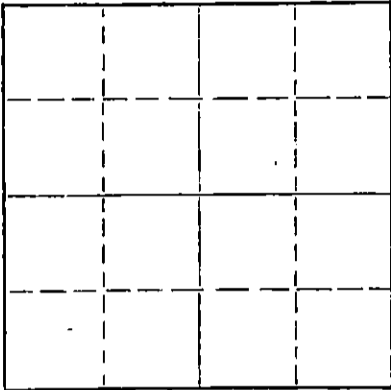

Locate well correctly on above Section Plat

Pratt County. Sec. 1 Twp. 29 Rge. 13 (E) W. (W)
Location as "NE/CNWxSWx" or footage from lines Gen. SE SE NW
Lease Owner Cities Service Oil Company
Lease Name Fincham "D" Well No. 1
Office Address Box 308, Great Bend, Kansas
Character of Well (completed as Oil, Gas or Dry Hole) Dry Hole
Date well completed July 30, 19 65
Application for plugging filed July 30, 19 65
Application for plugging approved July 30, 19 65
Plugging commenced July 30, 19 65
Plugging completed July 30, 19 65
Reason for abandonment of well or producing formation Dry Hole

If a producing well is abandoned, date of last production - 19 -
Was permission obtained from the Conservation Division or its agents before plugging was commenced? Yes

Name of Conservation Agent who supervised plugging of this well A. Elving
Producing formation _____ Depth to top _____ Bottom _____ Total Depth of Well 4760 Feet
Show depth and thickness of all water, oil and gas formations.

OIL, GAS OR WATER RECORDS

CASING RECORD

FORMATION	CONTENT	FROM	TO	SIZE	PUT IN	PULLED OUT
				8-5/8"	961'	None

Describe in detail the manner in which the well was plugged, indicating where the mud fluid was placed and the method or methods used in introducing it into the hole. If cement or other plugs were used, state the character of same and depth placed, from _____ feet to _____ feet for each plug set.

4760-300', heavy mud.
300-210', hulls, plug, 25 sacks cement.
210- 40', heavy mud.
40' to base of cellar, hulls, plug, 10 sacks cement.
(2 sacks cement in rat hole.)

RECEIVED
STATE CORPORATION COMMISSION

AUG 9 - 1965

CONSERVATION DIVISION
Wichita, Kansas

(If additional description is necessary, use BACK of this sheet)
Name of Plugging Contractor Leben Drilling, Inc.
Address Wichita, Kansas

STATE OF Kansas, COUNTY OF Barton, ss.
W. J. Devaney (employee of owner) of the above-described well, being first duly sworn on oath, says: That I have knowledge of the facts, statements, and matters herein contained and the log of the above-described well as filed and that the same are true and correct. So help me God.

(Signature) [Signature]
Box 308, Great Bend, Kansas
(Address)

SUBSCRIBED AND SWORN TO before me this 6th day of August, 19 65

My commission expires Dec. 6, 1966 [Signature] Notary Public.

AUG 19 1965

WELL RECORD

CONSERVATION DIVISION
Wichita, Kansas

WILDCAT _____
DISCOVERY _____
POOL _____

Company Cities Service Oil Company Well No. 1 Farm Fincham "D"
Location 2310' fr. N.L. & 2310' fr. W.L. Sec. 1 T. 29S R. 13W
Elev. Serv. 1915' K.B. D.F. 1912' Gr. 1910' Co. Pratt State Kansas
N. I. P. D & A A. I. P. _____ Grav. _____
Pay Zones _____
Perforations D & A
Acid _____ Hydrafrac _____
T. D. 4760' P. B. T. D. _____ N. T. D. _____ Drlg. Comm. 7/15/65 Drlg. Comp. 7/30/65

CASING RECORD:

8 5/8" @ 961' w/500 sacks.

<u>Formation Record</u>	<u>Depth</u>
Surface Clay	0- 25
Sand & Shale	190
Red Shale	645
Red Bed	1100
Shale & Shells	1800
Shale & Lime	1920
Lime & Shale	2475
Shale & Lime	2675
Lime and Shale	3730
Lime	4327
Lime & Chert	4525
Chert	4599
Lime & Chert	4674
Shale & Lime	4760

Contractor Leben Drlg. Co.

Electric Log Tops:

Council Grove	2405' (-490)
Topeka	3318' (-1403)
Heebner	3686' (-1771)
Lansing	3889' (-1974)
Base Kansas City	4263' (-2348)
Miss.	4356' (-2441)
Kinderhook	4444' (-2549)
Viola	4487' (-2572)
Simpson	4611' (-2696)
Arbuckle	4720' (-2805)
LTD	4762'

Slope Tests - Eastman

250'	1/4°
800'	1°
960'	1 1/4°
1465'	1°
1911'	3/4°
2280'	1°
2700'	1°
3183'	1 1/4°
3609'	1 3/4°
3948'	2°
4434'	1°