

ORIGINAL

COPY

CONFIDENTIAL

SIDE ONE

STATE CORPORATION COMMISSION OF KANSAS  
OIL & GAS CONSERVATION DIVISION  
WELL COMPLETION FORM  
ACO-1 WELL HISTORY  
DESCRIPTION OF WELL AND LEASE

API NO. 15- 067-21,110-0000

County Grant

W/2 NW NE Sec. 31 Twp. 29S Rge. 38  East West

4590 Ft. North from Southeast Corner of Section

2310 Ft. West from Southeast Corner of Section  
(NOTE: Locate well in section plat below.)


Lease Name Johnson Well # 1-31

Field Name S.W. Ulyssis

Producing Formation St. Louis

Elevation: Ground 3111 KB 3122

Total Depth 5800 PBDT 5743

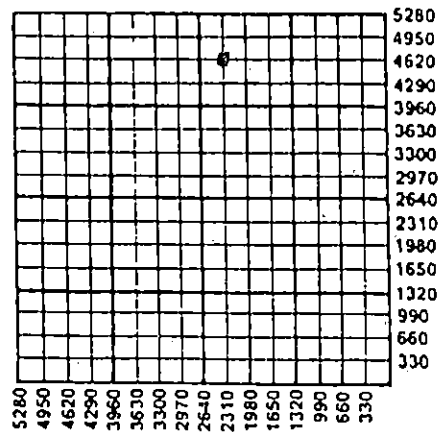

*AI I*

Amount of Surface Pipe Set and Cemented at 1769 Feet

Multiple Stage Cementing Collar Used?  Yes  No

If yes, show depth set \_\_\_\_\_ Feet

If Alternate II completion, cement circulated from \_\_\_\_\_

feet depth to \_\_\_\_\_ w/ \_\_\_\_\_ sx cmt.

Operator: License # 9953

Name: Harris Oil & Gas Company

Address 410 17th Street, Suite 2310  
Denver, CO 80202

City/State/Zip \_\_\_\_\_

Purchaser: Koch

Operator Contact Person: Bud Harris

Phone ( 303 ) 623-3336

Contractor: Name: Cheyenne Drilling, Inc.

License: 5382

Wellsite Geologist: Dan Sommer

Designate Type of Completion

- New Well  Re-Entry  Workover
- Oil  SWD  Temp. Abd.
- Gas  Inj  Delayed Comp.
- Dry  Other (Core, Water Supply, etc.)

If OWMO: old well info as follows:

Operator: \_\_\_\_\_

Well Name: \_\_\_\_\_

Comp. Date \_\_\_\_\_ Old Total Depth \_\_\_\_\_

Drilling Method:

- Mud Rotary  Air Rotary  Cable

12-1-90 12-9-90 1-3-91

Spud Date Date Reached TD Completion Date

**INSTRUCTIONS:** This form shall be completed in triplicate and filed with the Kansas Corporation Commission, 200 Colorado Derby Building, Wichita, Kansas 67202, within 120 days of the spud date of any well. Rule 82-3-130, 82-3-107 and 82-3-106 apply. Information on side two of this form will be held confidential for a period of 12 months if requested in writing and submitted with the form. See rule 82-3-107 for confidentiality in excess of 12 months. One copy of all wireline logs and drillers time log shall be attached with this form. ALL CEMENTING TICKETS MUST BE ATTACHED. Submit CP-4 form with all plugged wells. Submit CP-111 form with all temporarily abandoned wells. Any recompletion, workover or conversion of a well requires filing of ACO-2 within 120 days from commencement date of such work.

All requirements of the statutes, rules and regulations promulgated to regulate the oil and gas industry have been fully complied with and the statements herein are complete and correct to the best of my knowledge.

Signature [Signature]

Title \_\_\_\_\_ Date 2-14-91

Subscribed and sworn to before me this 14<sup>th</sup> day of February 1991.

Notary Public [Signature]

Date Commission Expires 03-28-94

**K.C.C. OFFICE USE ONLY**

F  Letter of Confidentiality Attached

C  Wireline Log Received

C  Drillers Timelog Received

**Distribution**

KCC  SWD/Rep  NGPA

KGS  Plug  Other

(Specify)