

plugged 9-16-87

STATE CORPORATION COMMISSION OF KANSAS
OIL & GAS CONSERVATION DIVISION
WELL COMPLETION OR RECOMPLETION FORM
ACO-1 WELL HISTORY
DESCRIPTION OF WELL AND LEASE

Operator: License # 5500
Name Jenkins & Sons Production, Inc.
Address Route 2, Box 19
City/State/Zip Arkansas City, KS, 67005

Purchaser: N/A

Operator Contact Person Pat Jenkins
Phone (316) 442-0267

Contractor: License # 5420
Name White & Ellis Drilling Co., Inc.

Wellsite Geologist Edward Broyles
Phone (316) 442-7503

Designate Type of Completion
 New Well Re-Entry Workover
 Oil SWD Temp Abd
 Gas Inj Delayed Comp.
 Dry Other (Core, Water Supply etc.)

If OWNED: old well info as follows:
Operator N/A
Well Name
Comp. Date Old Total Depth

WELL HISTORY

Drilling Method:
 Mud Rotary Air Rotary Cable
9/10/87 9/16/87 9/21/87
Spud Date Date Reached TD Completion Date
3271' D/A
Total Depth PBDT

Amount of Surface Pipe Set and Cemented at 260 feet
Multiple Stage Cementing Collar Used? Yes No
If yes, show depth set feet
If alternate 2 completion, cement circulated from 255 feet depth to surface, 220 SX cmt
Cement Company Name United Cementing
Invoice # 2528

API NO. 15-191-22,004-00-00
County Sumner
CW/2 SW SE Sec. 10 Twp. 35 Rge. 1 East West

660 Ft North from Southeast Corner of Section
2310 Ft West from Southeast Corner of Section
(Note: Locate well in section plat below)


Lease Name Crow Well # 1

Field Name South Haven

Producing Formation Layton

Elevation: Ground 1133 KB 1138

Section Plat

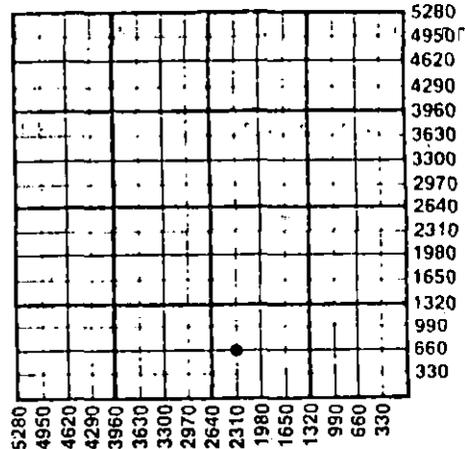

WATER SUPPLY INFORMATION

Disposition of Produced Water: Disposal
Docket # Repressuring

Questions on this portion of the ACO-1 call:

Water Resources Board (913) 296-3717

Source of Water:
Division of Water Resources Permit #

Groundwater Ft North from Southeast Corner (Well) Ft West from Southeast Corner of Sec Twp Rge East West

Surface Water 360 Ft North from Southeast Corner (Stream, pond etc) 2310 Ft West from Southeast Corner 11 Sec 35 Twp 1 Rge East West

Other (explain) (purchased from city, R.W.D. #)

INSTRUCTIONS: This form shall be completed in triplicate and filed with the Kansas Corporation Commission, 200 Colorado Derby Building, Wichita, Kansas 67202, within 120 days of the spud date of any well. Rule 82-3-130, 82-3-107 and 82-3-106 apply. Information on side two of this form will be held confidential for a period of 12 months if requested in writing and submitted with the form. See rule 82-3-107 for confidentiality in excess of 12 months. One copy of all wireline logs and drillers time log shall be attached with this form. Submit CP-4 form with all plugged wells. Submit CP-111 form with all temporarily abandoned wells.

All requirements of the statutes, rules and regulations promulgated to regulate the oil and gas industry have been fully complied with and the statements herein are complete and correct to the best of my knowledge.


Signature *Ronald Paul*

Title Vice-President Date 1/12/88

Subscribed and sworn to before me this 25th day of Jan 1988

Notary Public Cheri K. Posey

Date Commission Expires

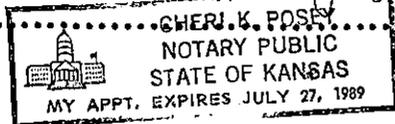

K.C.C. OFFICE USE ONLY
F Letter of Confidentiality Attached
C Wireline Log Received
C Drillers Timelog Received
Distribution
 KCC SWD/Rep NGPA
 KGS Plug Other
COM. ISSION (Specify)

CONSERVATION DIVISION
Wichita, Kansas

Form ACO-1 (5-86)

1-27-1988

Sec. 10, Twp. 35 Rge. 1 E

Operator Name Jenkins and Sons Production, Inc. Lease Name Crow Well # 1

Sec. 10 Twp. 35S Rge. 1 East West County Sumner

WELL LOG

INSTRUCTIONS: Show important tops and base of formations penetrated. Detail all cores. Report all drill stem tests giving interval tested, time tool open and closed, flowing and shut-in pressures, whether shut-in pressure reached static level, hydrostatic pressures, bottom hole temperature, fluid recovery, and flow rates if gas to surface during test. Attach extra sheet if more space is needed. Attach copy of log.

Drill Stem Tests Taken Yes No
 Samples Sent to Geological Survey Yes No
 Cores Taken Yes No

Formation Description
 Log Sample

Name	Top	Bottom
Cellar	0	7
Shale	7	786
Shale, Lime	1210	1622
Lime, Shale	1622	2490
Shale, Sand	2490	2533
Lime, Shale	2533	2793
Shale	2793	2830
Lime, Shale, Sand	2830	3023
Shale	3023	3258
Sand	3258	3271

Drill Stem Test: See Attached

Plugged and abandoned: See Attached

CASING RECORD <input checked="" type="checkbox"/> New <input type="checkbox"/> Used							
Report all strings set-conductor, surface, intermediate, production, etc.							
Purpose of String	Size Hole Drilled	Size Casing Set (In O.D.)	Weight Lbs/Ft.	Setting Depth	Type of Cement	#Sacks Used	Type and Percent Additives
Surface	12 1/4"	8 5/8"	24	261'	Class A	220	CC/3%
.....
.....
.....
PERFORATION RECORD				Acid, Fracture, Shot, Cement Squeeze Record			
Shots Per Foot	Specify Footage of Each Interval Perforated			(Amount and Kind of Material Used)			Depth
.....
.....
.....
.....
TUBING RECORD				Liner Run <input type="checkbox"/> Yes <input type="checkbox"/> No			
Size	Set At	Packer at					
.....					
Date of First Production		Producing Method					
.....		<input type="checkbox"/> Flowing <input type="checkbox"/> Pumping <input type="checkbox"/> Gas Lift <input type="checkbox"/> Other (explain).....					
Estimated Production Per 24 Hours	Oil	Gas	Water	Gas-Oil Ratio	Gravity		
	Bbls	MCF	Bbls	CFPB			
.....		

METHOD OF COMPLETION

Production Interval

Disposition of gas: Vented Open Hole Perforation
 Sold Other (Specify)
 Used on Lease Dually Completed
 Commingled



Ricketts Testing

Company Jenkins & Son Production, Inc. Lease & Well No. Crow #1
 Elevation _____ Formation Layton Effective Pay _____ ft. Ticket No. 952
 Date 9-16-87 Sec. 10 Twp. 35 Range 1W County Sumner State Kansas
 Test Approved by Ed Broyles Ricketts Representative Steve Waggoner

Formation Test No. 1 Interval Tested from 3264 ft. to 3271 ft. Total Depth 3271 ft.
 Packer Depth 3264 ft. Size 6 3/4 in. Packer Depth _____ ft. Size _____ in.
 Packer Depth 3261 ft. Size 6 3/4 in. Packer Depth _____ ft. Size _____ in.

Depth of Selective Zone Set _____
 Top Recorder Depth (Inside) 3252 A/P ft. Recorder Number 13767 Cap. 4275
 Bottom Recorder Depth (Outside) 3268 ft. Recorder Number 13565 Cap. 4475
 Below Straddle Recorder Depth _____ ft. Recorder Number _____ Cap. _____

Drilling Contractor White & Ellis #7 Drill Collar Length 121 I.D. 2.25 in.
 Mud Type Chemical Viscosity 66 Weight Pipe Length _____ I.D. _____ in.
 Weight 9.4 Water Loss 9.9 cc. Drill Pipe Length 3123 I.D. 3.25 in.
 Chlorides 3,500 P.P.M. Test Tool Length 20 ft. Tool Size 5 1/2 in.
 Jars: Make --- Serial Number _____ Anchor Length 7 ft. Size 5 1/2 in.
 Did Well Flow? No Reversed Out No Surface Choke Size 3/4 in. Bottom Choke Size 3/4 in.
 Main Hole Size 7 7/8 in. Tool Joint Size 4 1/2 x h in.

Blow: Steady blow, building to 10" Initial Flow Period.
Steady blow, building to 6 1/2" Final Flow Period.

Recovered 270 ft. of Muddy water.
 Recovered _____ ft. of _____
 Recovered _____ ft. of _____
 Recovered _____ ft. of _____
 Recovered _____ ft. of _____

Remarks: DST Fluid Chlorides 36,000 PPM

Time Set Packer (s)	<u>10:45</u>	A.M. RXX	Time Started Off Bottom	<u>1:45</u>	XXX P.M.	Maximum Temperature	<u>104°</u>
Initial Hydrostatic Pressure	(A)		<u>1703</u>		P.S.I.		
Initial Flow Period	Minutes	<u>60</u>	(B)	<u>34</u>	P.S.I. to		
			(C)	<u>114</u>	P.S.I.		
Initial Closed In Period	Minutes	<u>30</u>	(D)	<u>1298</u>	P.S.I.		
Final Flow Period	Minutes	<u>60</u>	(E)	<u>144</u>	P.S.I.		
			(F)	<u>159</u>	P.S.I.		
Final Closed In Period	Minutes	<u>30</u>	(G)	<u>1288</u>	P.S.I.		
Final Hydrostatic Pressure	(H)		<u>1689</u>		P.S.I.		

STATE CORP. CONTROL DIV
 TO JAN 27 1988
 CONSERVATION DIVISION
 Wichita, Kansas

RICKETTS TESTING

Pressure Data

Date 9-16-87 Test Ticket No. 952
 Recorder No. 13767 Capacity 4275 Location 3252 Ft.
 Clock No. _____ Elevation _____ Well Temperature 104 °F

Point	Pressure		Time Given	Time Computed
A Initial Hydrostatic Mud	<u>1703</u>	P.S.I.	<u>10:45</u> A	
B First Initial Flow Pressure	<u>34</u>	P.S.I.	<u>60</u> Mins.	<u>60</u> Mins.
C First Final Flow Pressure	<u>114</u>	P.S.I.	<u>30</u> Mins.	<u>30</u> Mins.
D Initial Closed-in Pressure	<u>1298</u>	P.S.I.	<u>60</u> Mins.	<u>60</u> Mins.
E Second Initial Flow Pressure	<u>144</u>	P.S.I.	<u>30</u> Mins.	<u>30</u> Mins.
F Second Final Flow Pressure	<u>159</u>	P.S.I.		
G Final Closed-in Pressure	<u>1288</u>	P.S.I.		
H Final Hydrostatic Mud	<u>1689</u>	P.S.I.		

PRESSURE BREAKDOWN

Point Mins.	First Flow Pressure		Initial Shut-In		Second Flow Pressure		Final Shut-In	
	Breakdown:	Inc.	Breakdown:	Inc.	Breakdown:	Inc.	Breakdown:	Inc.
	of <u>5</u> mins. and a		of <u>3</u> mins. and a		of <u>5</u> mins. and a		of <u>3</u> mins. and a	
	final inc. of _____ Min.		final inc. of _____ Min.		final inc. of _____ Min.		final inc. of _____ Min.	
Point Mins.	Press.	Point Minutes	Press.	Point Minutes	Press.	Point Minutes	Press.	
P 1 0	34	0	114	0	144	0	159	
P 2 5	35	3	1121	5	144	3	1010	
P 3 10	40	6	1196	10	144	6	1172	
P 4 15	48	9	1230	15	144	9	1215	
P 5 20	55	12	1251	20	144	12	1240	
P 6 25	63	15	1263	25	144	15	1255	
P 7 30	72	18	1273	30	145	18	1265	
P 8 35	79	21	1281	35	148	21	1274	
P 9 40	86	24	1288	40	150	24	1280	
P 10 45	93	27	1294	45	152	27	1285	
P 11 50	99	30	1298	50	154	30	1288	
P 12 55	108	33		55	157	33		
P 13 60	114	36		60	159	36		
P 14 65		39		65	168	39		
P 15 70		42		70		42		
P 16 75		45		75		45		
P 17 80		48		80		48		
P 18 85		51		85		51		
P 19 90		54		90		54		
P 20 95		57				57		
		60				60		

STAT 60 INC. 159
 27 1988
 CONSERVATION DIVISION
 Wichita, Kansas