

STATE OF KANSAS  
STATE CORPORATION COMMISSION  
CONSERVATION DIVISION  
200 Colorado Derby Building  
Wichita, Kansas 67202

FORM CP-1  
Rev. 03/92

6-1-93

WELL PLUGGING APPLICATION FORM  
(PLEASE TYPE FORM and File ONE Copy)

API # 15-007-22,367-000 (Identifier number of this well). This must be listed for wells drilled since 1967; if no API# was issued, indicate spud or completion date.

WELL OPERATOR Pickrell Drilling Co., Inc. KCC LICENSE # 5123  
(owner/company name) (operator's)

ADDRESS 110 N. Market, Suite 205 CITY Wichita

STATE Kansas ZIP CODE 67202 CONTACT PHONE # (316) 262-8427

LEASE Reeves "E" WELL# 1 SEC. 13 T. 31S R. 12 (East/West)

- NW - NE - SW SPOT LOCATION/QQQQ COUNTY Barber

2310 FEET (in exact footage) FROM (S)N (circle one) LINE OF SECTION (NOT Lease Line)

3630 FEET (in exact footage) FROM (E)W (circle one) LINE OF SECTION (NOT Lease Line)

Check One: OIL WELL  GAS WELL  D&A  SWD/ENHR WELL  DOCKET# \_\_\_\_\_

CONDUCTOR CASING SIZE \_\_\_\_\_ SET AT \_\_\_\_\_ CEMENTED WITH \_\_\_\_\_ SACKS

SURFACE CASING SIZE 8% SET AT 232 CEMENTED WITH 165 SACKS

PRODUCTION CASING SIZE 4 1/2 SET AT 3520 CEMENTED WITH 150 SACKS

LIST (ALL) PERFORATIONS and BRIDGEPLUG SETS: Elgin Sd. Perfs 3346-3351

ELEVATION 1569 KB T.D. 4345 PBDT 3489 ANHYDRITE DEPTH \_\_\_\_\_  
(G.L./K.B.) (Stone Corral Formation)

CONDITION OF WELL: GOOD  POOR \_\_\_\_\_ CASING LEAK \_\_\_\_\_ JUNK IN HOLE \_\_\_\_\_

PROPOSED METHOD OF PLUGGING Plug back with sand to 3300 ft. Use dump bailer to spot 5 Sx. of cement on sand. Cut and recover casing. Plug top hole per KCC instructions (316) 263-8809.

(If additional space is needed attach separate page)

IS WELL LOG ATTACHED TO THIS APPLICATION AS REQUIRED? Yes IS ACO-1 FILED? Yes

If not explain why? \_\_\_\_\_

PLUGGING OF THIS WELL WILL BE DONE IN ACCORDANCE WITH K.S.A. 55-101 et. seq. AND THE RULES AND REGULATIONS OF THE STATE CORPORATION COMMISSION.

LIST NAME OF COMPANY REPRESENTATIVE AUTHORIZED TO BE IN CHARGE OF PLUGGING OPERATIONS:

Don Aumiller PHONE# (316) 532-3511

ADDRESS Box 290 City/State Kingman, Kansas 67068

PLUGGING CONTRACTOR Clarke Corp. KCC LICENSE # 5105  
(company name) (contractor's)

ADDRESS 107 W. Fowler, Medicine Lodge, Ks. 67104 PHONE # (316) 886-3805

PROPOSED DATE AND HOUR OF PLUGGING (If Known?) June 8, 1993

PAYMENT OF THE PLUGGING FEE (K.A.R. 82-3-118) WILL BE GUARANTEED BY OPERATOR OR AGENT

DATE: 05-27-93 AUTHORIZED OPERATOR/AGENT: Jack Gurley  
(Jack Gurley)


RECEIVED  
STATE CORPORATION COMMISSION  
JUN 1 1993  
CONSERVATION DIVISION  
Wichita, Kansas

D

BAKER SERVICE TOOLS - TALLY PAD

New Completion     Workover

Oil Company \_\_\_\_\_ Well No. 1 Field Mott Ranch Lease Reeves E  
Company Man \_\_\_\_\_ Date Drilled 6/91 County Barber State KS

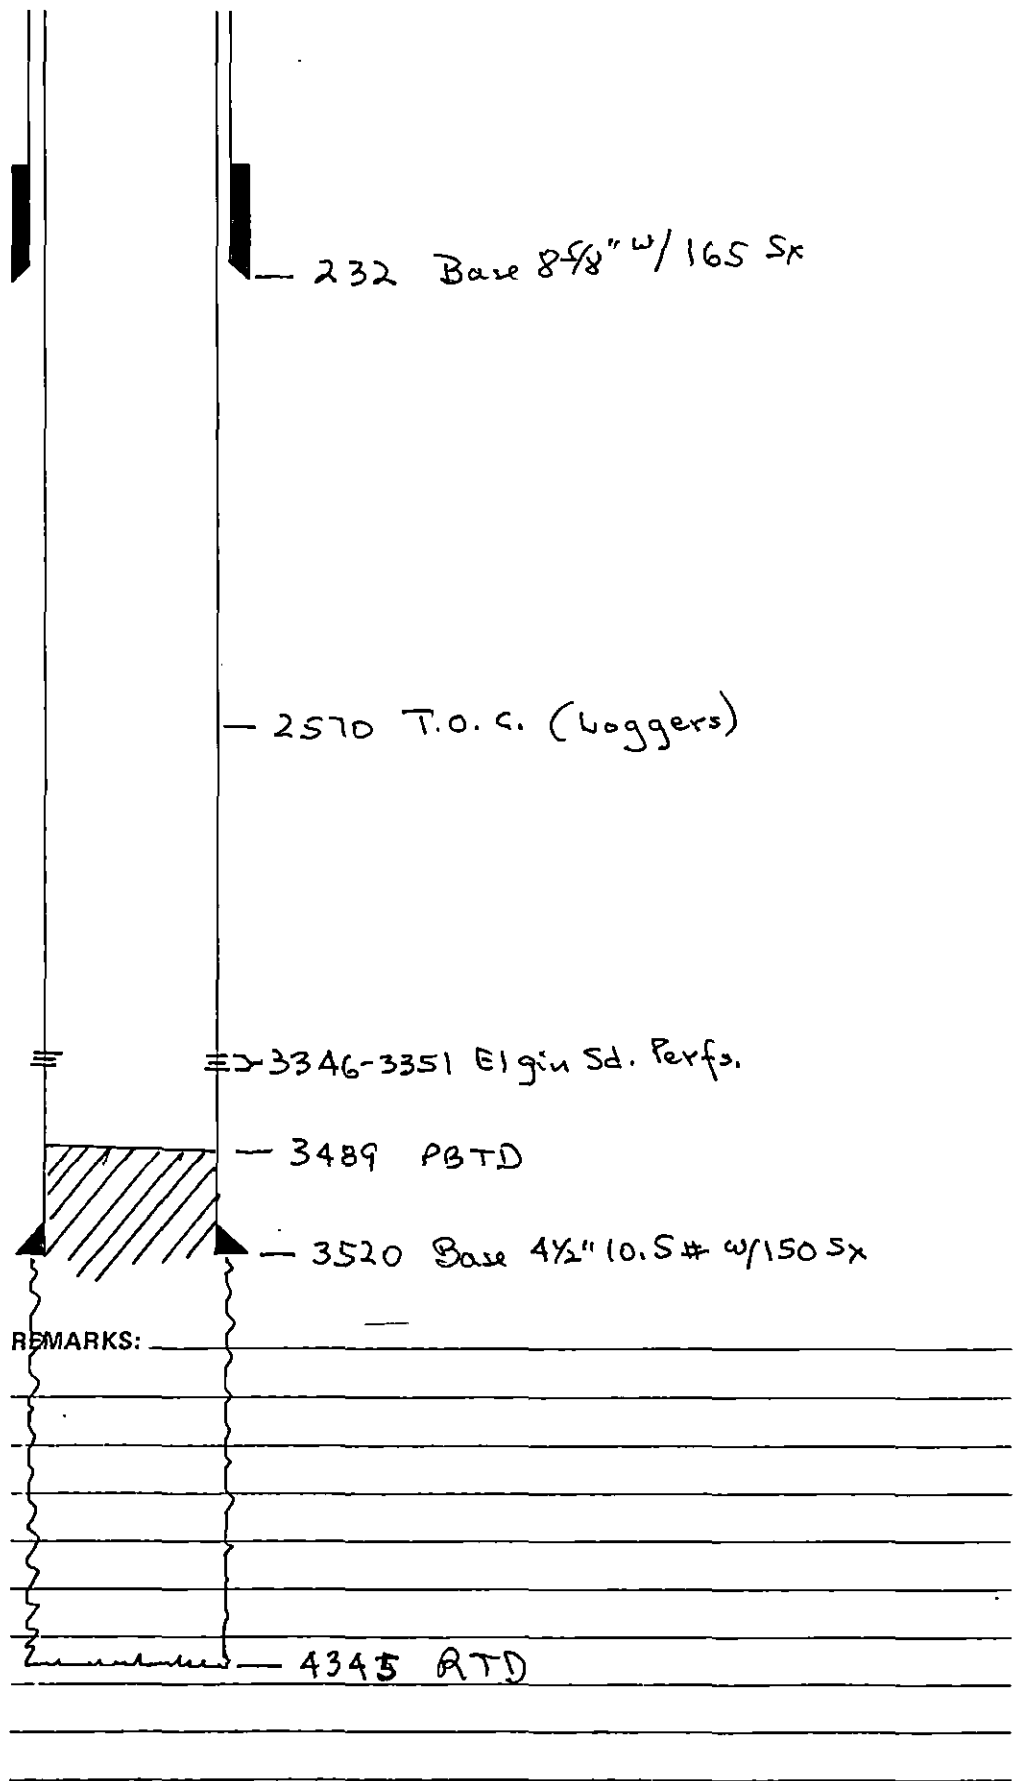

— 232 Base 8 7/8" w/165 Sx

— 2570 T.O.C. (Loggers)

≡ 3346-3351 Elgin Sd. Perfs.

— 3489 PBTD

— 3520 Base 4 1/2" 10.5# w/150 Sx

REMARKS: \_\_\_\_\_  
\_\_\_\_\_  
\_\_\_\_\_  
\_\_\_\_\_  
\_\_\_\_\_  
\_\_\_\_\_  
\_\_\_\_\_ 4345 RTD

RECEIVED  
STATE COORDINATION COMMISSION  
JUN 1 1993  
CONSERVATION DIVISION  
Wichita, Kansas

Joan Finney  
Governor

Jim Robinson  
Chairman

F. S. Jack Alexander  
Commissioner

Rachel C. Lipman  
Commissioner

Judith McConnell  
Executive Director

Brian Moline  
General Counsel



# Kansas Corporation Commission

## NOTICE OF RECEIPT OF WELL PLUGGING APPLICATION

June 1, 1993

Pickrell Drilling Co  
110 N Market 205  
Wichita KS 67202

Reeves E 1  
API 15-007-22, 367000  
2310' FSL-3630' FEL  
Sec. 13-31-12W  
Barber County

Dear Pickrell Drilling,


This letter is to notify you that the Conservation Division is in receipt of your plugging proposal, form CP-1, for the above-captioned well.

Your CP-1 has been reviewed by the Conservation Division central office for completeness and to verify license numbers. The plugging proposal will now be forwarded to the district office listed below for review of your proposed method of Please contact the district office for approval of your proposed plugging method at least at five (5) days before plugging the well, pursuant to K.A.R. 82-3-113 (b). If a workover pit will be used during the plugging of the well it must be permitted. A CDP-1 form must be filed and approved prior to the use of the pit.

It has recently come to my attention that the form CP-1 has been filed by operators other than the owner or operator of the well and without the consent of the owner or operator. The Conservation Division's review of form CP-1, either in the central or district office, does not include an inquiry into well ownership or the filing operator's legal right to plug the well.

This notice in no way constitutes authorization to plug the above-captioned well by persons not having legal rights of ownership or interest in the well. This notice is void after ninety (90) days from the above date.

Sincerely,

  
David P. Williams  
Production Supervisor

Conservation Division  
William R. Bryson  
Director  
200 Colorado Derby Bldg.  
202 W. 1st Street  
Wichita, Kansas 67202-1286  
Telephone (316) 263-3238

District: #1 304 W. McArtor  
Dodge City, KS 67801  
(316) 225-6760