

STATE OF KANSAS
STATE CORPORATION COMMISSION
CONSERVATION DIVISION
200 Colorado Derby Building
Wichita, Kansas 67202

FORM CP-1
Rev. 03/92

6-23-93

WELL PLUGGING APPLICATION FORM
(PLEASE TYPE FORM and File ONE Copy)

API # 15-007-20,638-400-01 (Identifier number of this well). This must be listed for wells drilled since 1967; if no API# was issued, indicate spud or completion date.

WELL OPERATOR Trisum Ventures, Inc. KCC LICENSE # 5414 7-93
(owner/company name) (operator's)
ADDRESS 922 Union Center Bldg. CITY Wichita,
STATE Kansas ZIP CODE 67202 CONTACT PHONE # (316) 263-0898
LEASE Pratt WELL# 2 SEC. 18 T. 31S R. 13 (~~East~~/West)

Approx - SE - NW - NE SPOT LOCATION/QQQQ COUNTY Barber

4180 FEET (in exact footage) FROM (S)/N (circle one) LINE OF SECTION (NOT Lease Line)
1670 FEET (in exact footage) FROM (E)/W (circle one) LINE OF SECTION (NOT Lease Line)

Check One: OIL WELL GAS WELL D&A SWD/ENHR WELL DOCKET#

CONDUCTOR CASING SIZE SET AT CEMENTED WITH SACKS
SURFACE CASING SIZE 8 5/8" SET AT 292' CEMENTED WITH washdown SACKS
PRODUCTION CASING SIZE 5 1/2" SET AT 4564' CEMENTED WITH 150 SACKS

LIST (ALL) PERFORATIONS and BRIDGEPLUG SETS: 4564-65'; 4497-99'

ELEVATION 1642' T.D. 4565' PBDT 4565' ANHYDRITE DEPTH 580' Est.
(G.L./K.B.) (Stone Corral Formation)

CONDITION OF WELL: GOOD POOR CASING LEAK JUNK IN HOLE

PROPOSED METHOD OF PLUGGING Cement & mud

(If additional space is needed attach separate page)

IS WELL LOG ATTACHED TO THIS APPLICATION AS REQUIRED? yes ^{NO} IS ACO-1 FILED? Yes

If not explain why?

PLUGGING OF THIS WELL WILL BE DONE IN ACCORDANCE WITH K.S.A. 55-101 et. seq. AND THE RULES AND REGULATIONS OF THE STATE CORPORATION COMMISSION.

LIST NAME OF COMPANY REPRESENTATIVE AUTHORIZED TO BE IN CHARGE OF PLUGGING OPERATIONS:

Ronald S. Schraeder PHONE# (316) 263-0898

ADDRESS 922 Union Center Bldg. City/State Wichita, Kansas 67202

PLUGGING CONTRACTOR Shawnee Well Service KCC LICENSE # 30346
(company name) (contractor's)

ADDRESS 127 E. "B" ; Attica, Ks 67009 PHONE # (316) 254-7893

PROPOSED DATE AND HOUR OF PLUGGING (If Known?) Will contact District Office

PAYMENT OF THE PLUGGING FEE (K.A.R. 82-3-118) WILL BE GUARANTEED BY OPERATOR OR AGENT

DATE: Feb. 19, 1993 AUTHORIZED OPERATOR/AGENT: Randall Anderson JUN 23 1993
(signature)

Randall Anderson, Pres.

RECEIVED
STATE CORPORATION COMMISSION
Wichita, Kansas

MAILED COPY OF R A GUARD LOG WITH APPLICATION TO KCC


*in January, 1993.
log has already been
forwarded to KGS.*

RECEIVED
STATE CONSERVATION COMMISSION

JUN 23 1993

CONSERVATION DIVISION
Wichita, Kansas

SE NW NE Sec 18-T31S-R13W
Barber County, Kansas

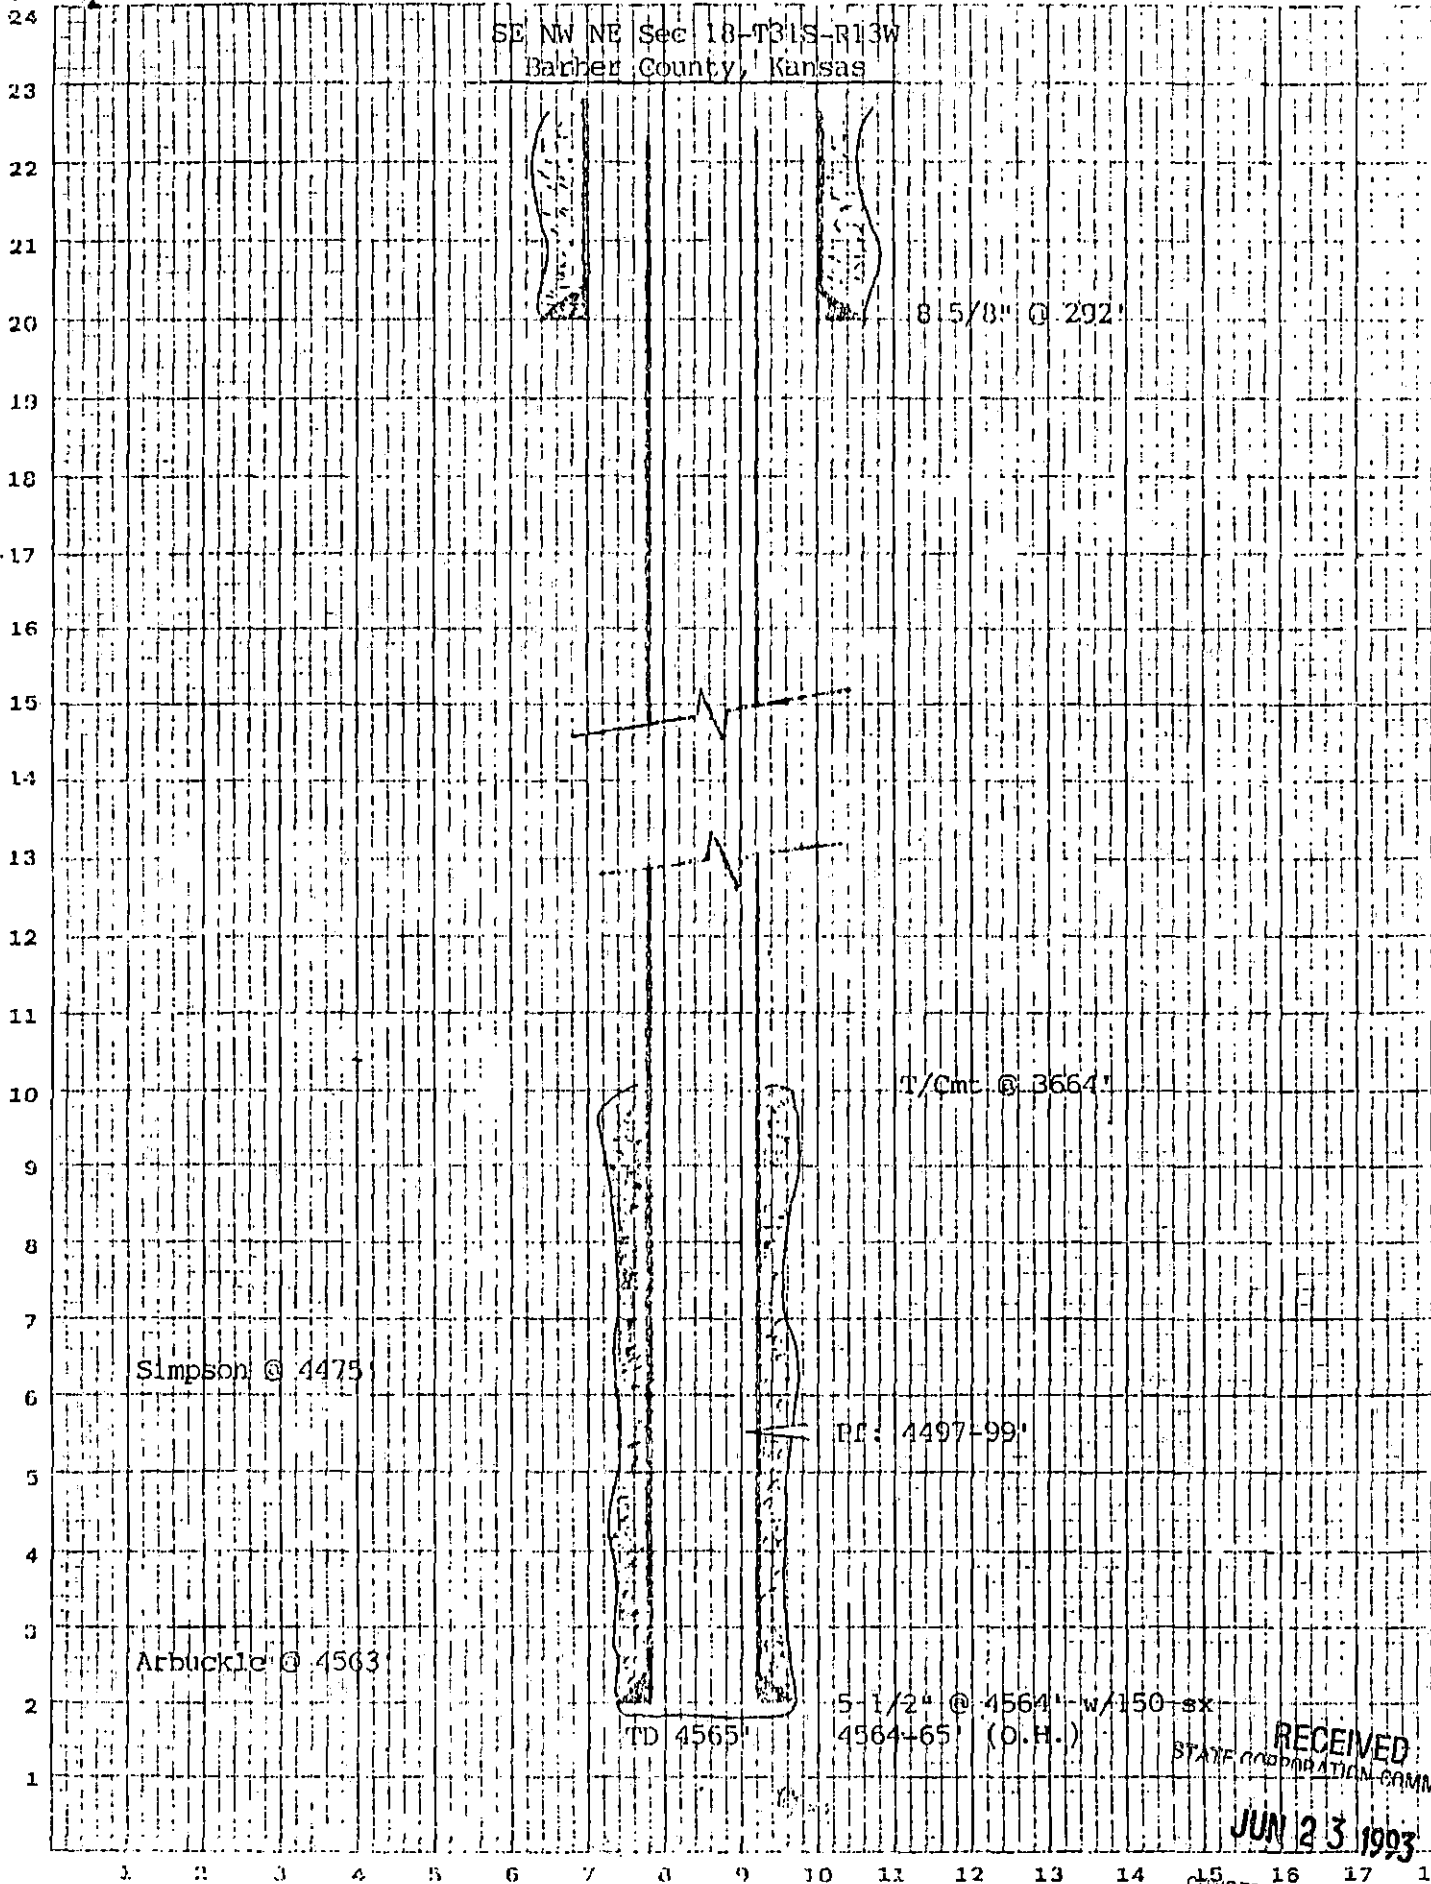

RECEIVED
 STATE CORPORATION COMMISSION
 JUN 23 1993
 CONSERVATION DIVISION
 Wichita, Kansas

Joan Finney
Governor

Jim Robinson
Chairman

F. S. Jack Alexander
Commissioner

Rachel C. Lipman
Commissioner

Judith McConnell
Executive Director

Brian Moline
General Counsel



Kansas Corporation Commission

NOTICE OF RECEIPT OF WELL PLUGGING APPLICATION

June 23, 1993

Trisum Ventures Inc
922 Union Center Bldg
Wichita KS 67202

Pratt #2
API 15-007-20,638-0001
4180 FSL 1670 FEL
Sec. 18-31S-13W
Barber County

Dear Ronald S. Schraeder,

This letter is to notify you that the Conservation Division is in receipt of your plugging proposal, form CP-1, for the above-captioned well.

Your CP-1 has been reviewed by the Conservation Division central office for completeness and to verify license numbers. The plugging proposal will now be forwarded to the district office listed below for review of your proposed method of plugging. Please contact the district office for approval of your proposed plugging method at least at five (5) days before plugging the well, pursuant to K.A.R. 82-3-113 (b). If a workover pit will be used during the plugging of the well it must be permitted. A CDP-1 form must be filed and approved prior to the use of the pit.

It has recently come to my attention that the form CP-1 has been filed by operators other than the owner or operator of the well and without the consent of the owner or operator. The Conservation Division's review of form CP-1, either in the central or district office, does not include an inquiry into well ownership or the filing operator's legal right to plug the well.

This notice in no way constitutes authorization to plug the above-captioned well by persons not having legal rights of ownership or interest in the well. This notice is void after ninety (90) days from the above date.

Sincerely,

A handwritten signature in cursive script, appearing to read "David P. Williams".

David P. Williams
Production Supervisor

Conservation Division
William R. Bryson
Director
200 Colorado Derby Bldg.
202 W. 1st Street
Wichita, Kansas 67202-1286
Telephone (316) 263-3238

District: #1 304 W. McArtor
Dodge City KS 67801
(316) 225-6760