

STATE OF KANSAS  
STATE CORPORATION COMMISSION

Give All Information Completely  
Make Required Affidavit  
Mail or Deliver Report to:  
Conservation Division  
State Corporation Commission  
800 Biting Building  
Wichita, Kansas

65-61

WELL PLUGGING RECORD

Morton County, Sec. 33 Twp. 34 Rge. (E) 42 (W)

Location as "NE/CNW/SW" or footage from lines C SE

Lease Owner Colorado Oil and Gas Corporation

Lease Name Farm Mortgage Well No. 1-33

Office Address P. O. Box 999, Liberal, Kansas

Character of Well (completed as Oil, Gas or Dry Hole) Oil

Date well completed 3-12 19 57

Application for plugging filed 5-9 19 61

Application for plugging approved 5-17 19 61


Plugging commenced 5-17 19 61

Plugging completed 5-22 19 61

Reason for abandonment of well or producing formation Non Commercial

If a producing well is abandoned, date of last production September 19 59

Was permission obtained from the Conservation Division or its agents before plugging was commenced? Yes

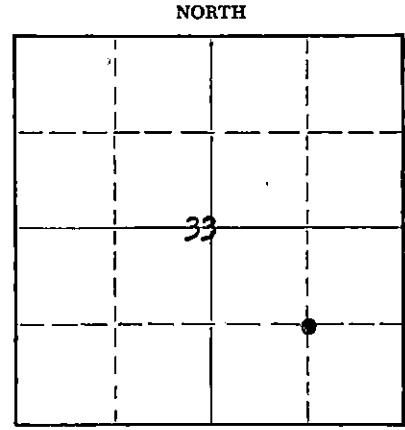

Locate well correctly on above Section Plat

Name of Conservation Agent who supervised plugging of this well W. L. LeKamp

Producing formation U. Keyes Depth to top 4398 Bottom 4417 Total Depth of Well 4440 Feet

Show depth and thickness of all water, oil and gas formations.

OIL, GAS OR WATER RECORDS

CASING RECORD

| FORMATION | CONTENT | FROM | TO   | SIZE   | PUT IN | PULLED OUT |
|-----------|---------|------|------|--------|--------|------------|
| U. Keyes  | Oil     | 4398 | 4403 | 9 5/8" | 1186   | None       |
| U. Keyes  | Oil     | 4412 | 4417 | 7"     | 4770   | 1302       |
|           |         |      |      |        |        |            |
|           |         |      |      |        |        |            |
|           |         |      |      |        |        |            |
|           |         |      |      |        |        |            |

Describe in detail the manner in which the well was plugged, indicating where the mud fluid was placed and the method or methods used in introducing it into the hole. If cement or other plugs were used, state the character of same and depth placed, from \_\_\_\_\_ feet to \_\_\_\_\_ feet for each plug set.

Spotted 5 sacks cement on bottom; filled hole with mud to 600'; cemented with 20 sacks; mud to 40'; set wooden bridge plug; rock to 30'; cemented with 10 sacks to 3' below ground level.

RECEIVED  
STATE CORPORATION COMMISSION

JUN 5 1961

CONSERVATION DIVISION  
Wichita, Kansas

(If additional description is necessary, use BACK of this sheet)

Name of Plugging Contractor Knight Casing Pulling Co.

Address Chase, Kansas

STATE OF Kansas, COUNTY OF Seward, ss.  
J. A. Ziser

(employee of owner) or (owner or operator) of the above-described well, being first duly sworn on oath, says: That I have knowledge of the facts, statements, and matters herein contained and the log of the above-described well as filed and that the same are true and correct. So help me God.

(Signature) *J. A. Ziser*

P. O. Box 999, Liberal, Kansas (Address)

SUBSCRIBED AND SWORN TO before me this 2nd day of June, 19 61

*William B. Claunch*  
Notary Public.

My commission expires 11-1-62

Company-COLORADO OIL & GAS  
Farm-Farm Mortgage 1-33

SEC. 33 T. 34 R. 42  
C SE/4

Total Depth 4668 PBD 4440  
Comm Comp 3-12-57  
Contractor Holm Drlg. Co.

County Morton  
Kansas

CASING:  
9 5/8" 1186

Elevation 3536GL  
3542LS

Figures Indicate Bottom of Formation

|                   |           |
|-------------------|-----------|
| surface-clay-sand | 0-220     |
| red bed-shells    | 500       |
| shale-shells      | 1340      |
| anhydrite         | 1400      |
| shale-shells      | 1695      |
| anhydrite         | 1765      |
| shale-shells      | 1795      |
| Dolomite          | 1903      |
| lime-shale        | 2630      |
| lime-shale        | 2780-92   |
| lime-shale        | 2792-98   |
| lime-shale        | 2819      |
| lime-shale        | 2819-25   |
| lime-shale        | 2776-2826 |
| lime-shale        | 2826-40   |
| lime-shale        | 2826-40   |
| lime-shale        | 2840-50   |
| lime-shale        | 2850-58   |
| lime-shale        | 2858-68   |
| lime-shale        | 2850-86   |
| lime-shale        | 3330      |
| shale-sand        | 3347      |
| lime-shale        | 3429      |
| lime              | 3436      |
| lime-shale        | 3454      |
| lime              | 3482      |
| lime-shale        | 3544      |
| lime-shale        | 3572      |
|                   | 3607      |
| lime-shale        | 3619      |
| lime-sand         | 3761      |
| lime sdy          | 3766      |
| lime-shale        | 3990      |
| lime              | 4050      |
| lime-shale        | 4300      |
| shale             | 4418      |
| lime-shale        | 4466      |
| shale             | 4466-86   |
| shale             | 4486      |
| shale             | 4538      |
|                   | 4591      |
| lime-shale        | 4668      |

TOPS: Scout

|             |      |
|-------------|------|
| Elmont      | 2857 |
| Lansing     | 3275 |
| Atoka       | 3904 |
| Morrow      | 4160 |
| Morrow sand | 4503 |
| Keyes sand  | 4559 |
| Mississippi | 4597 |
| Chester     | 4611 |

Far. Cont. ur. ever.

**RECEIVED**  
STATE CORPORATION COMMISSION

JUN 28 1961

CONSERVATION DIVISION