

7-5-73

STATE OF KANSAS  
STATE CORPORATION COMMISSION


Form CP-4

Give All Information Completely  
Make Required Affidavit  
Mail or Deliver Report to:  
Conservation Division  
State Corporation Commission  
P. O. Box 17027  
Wichita, Kansas 67217  
NORTH

WELL PLUGGING RECORD

Morton County, Sec. 4, Twp. 34 Rge. (E) 42 (W)

Location as "NE/CNW/SW" or footage from lines 175' S of G SE NW  
Lease Owner Colorado Oil & Gas Corporation  
Lease Name McClain Well No. 22-4  
Office Address P.O. Box 749, Denver, Colorado 80201  
Character of Well (completed as Oil, Gas or Dry Hole) Dry Hole  
Date well completed June 8, 1973  
Application for plugging filed June 8, 1973  
Application for plugging approved June 8, 1973  
Plugging commenced June 8, 1973  
Plugging completed June 9, 1973  
Reason for abandonment of well or producing formation

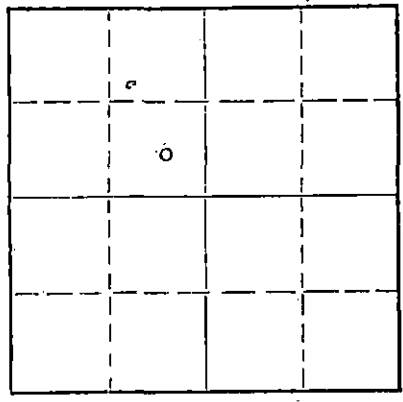

Locate well correctly on above Section Plat

If a producing well is abandoned, date of last production 19  
Was permission obtained from the Conservation Division or its agents before plugging was commenced? Yes

Name of Conservation Agent who supervised plugging of this well Edgar Eaves  
Producing formation Depth to top Bottom Total Depth of Well 4,732 Feet  
Show depth and thickness of all water, oil and gas formations.

OIL, GAS OR WATER RECORDS CASING RECORD

FORMATION	CONTENT	FROM	TO	SIZE	PUT IN	PULLED OUT
				13-3/8	133'	None
				8-5/8"	1,232'	None

Describe in detail the manner in which the well was plugged, indicating where the mud fluid was placed and the method or methods used in introducing it into the hole. If cement or other plugs were used, state the character of same and depth placed, from feet to feet for each plug set.

4,732' to 1,000' - Heavy Mud  
1,000' to 900' - 35 sacks cement  
900' to 45' - Heavy mud  
45' to surface - 15 sacks cement

RECEIVED  
STATE CORPORATION COMMISSION  
JUL 5 1973  
CONSERVATION DIVISION  
Wichita, Kansas

(If additional description is necessary, use BACK of this sheet)  
Name of Plugging Contractor Gabbert-Jones, Inc.  
Address 830 Sutton Place, Wichita, Kansas

STATE OF Colorado, COUNTY OF Denver, ss.  
R.S. McDonald (employee of owner) or (owner or operator) of the above-described well, being first duly sworn on oath, says: That I have knowledge of the facts, statements, and matters herein contained and the log of the above-described well as filed and that the same are true and correct. So help me God.

(Signature) R.S. McDonald  
P. O. Box 749, Denver, Colorado 80201  
(Address)

SUBSCRIBED AND SWORN to before me this 2 day of July, 1973  
C. M. Smith  
Notary Public.

My commission expires Aug. 25, 1976

