

1-18-82

STATE CORPORATION COMMISSION

JAN 18 1982

STATE OF KANSAS  
STATE CORPORATION COMMISSION

WELL PLUGGING RECORD

CONSERVATION DIVISION

Give All Information Completely  
Make Required Affidavit  
Mail or Deliver Report to  
Conservation Division  
State Corporation Comm.  
245 North Water  
Wichita, KS 67202

Morton County, Sec. 11 Township 34S Range 42 E/W  
Location as "NE/CNW/SW" or footage from lines

NE SE/4  
Lease Owner Anadarko Production Company  
Lease Name DURHAM "A" Well No. 1

Office Address P. O. Box 351, Liberal, Kansas 67901  
Character of Well (Completed as Oil, Gas or Dry Hole)

DRY HOLE


Date Well completed November 14 1981  
Application for plugging filed January 8 1982  
Application for plugging approved verbal November 13 1981  
Plugging commenced November 14 1981  
Plugging completed November 14 1981  
Reason for abandonment of well or producing formation

DRY HOLE

If a producing well is abandoned, date of last production 19

Was permission obtained from the Conservation Division or its agents before plugging was commenced? YES

Name of Conservation Agent who supervised plugging of this well Clarence Thomas  
Producing formation Depth to top Bottom Total Depth of Well 5355'  
Show depth and thickness of all water, oil and gas formations.

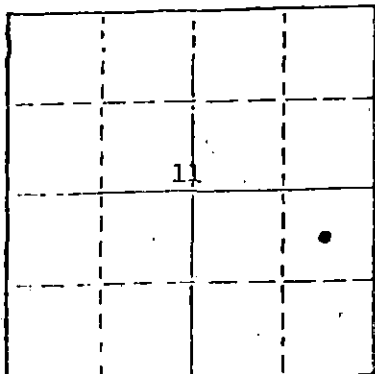

Locate well correctly on above Section Plat

OIL, GAS OR WATER RECORDS

CASING RECORD

| FORMATION | CONTENT | FROM | TO | SIZE   | PUT IN | PULLED OUT |
|-----------|---------|------|----|--------|--------|------------|
|           |         |      |    | 8-5/8" | 1037   | -0-        |
|           |         |      |    |        |        |            |
|           |         |      |    |        |        |            |
|           |         |      |    |        |        |            |

Describe in detail the manner in which the well was plugged, indicating where the mud fluid was placed and the method or methods used in introducing it into the hold. If cement or other plugs were used, state the character of same and depth placed, from feet to feet for each plug set.

Spotted 25 sxs cmt 4100-4150'; spotted 25 sxs cmt 1340-1300; spotted 50 sxs cmt 1200-1100'.  
10 sxs 40-0, 5 sxs cmt each in rathole and mousehole.

(If additional description is necessary, use BACK of this sheet)

Name of Plugging Contractor Johnson Drilling Co., Inc.

STATE OF KANSAS COUNTY OF SEWARD, ss.  
Paul Campbell (employee of owner) or (owner or operator)  
of the above-described well, being first duly sworn on oath, says: That I have knowledge of the facts, statements, and matters herein contained and the log of the above-described well as filed and that the same are true and correct. So help me God.

(Signature) Paul Campbell  
P. O. Box 351, Liberal, Kansas 67901  
(Address)

SUBSCRIBED AND SWORN TO before me this 15th day of January, 1982

My commission expires BEVERLY J. WILLIAMS  
Notary Public, Seward County, Kansas  
November 21, 1982

Beverly J. Williams  
Notary Public.