

5-9-67

STATE OF KANSAS  
STATE CORPORATION COMMISSION

Form CP-4

Give All Information Completely  
Make Required Affidavit  
Mail or Deliver Report to:  
Conservation Division  
State Corporation Commission  
212 No. Market  
Wichita, Kansas

WELL PLUGGING RECORD

Morton County, Sec. 13 Twp. 34S Rge. (E) 42 (W)

Location as "NE/CNWxSWx" or footage from lines 150' N of C NE NE

Lease Owner Anadarko Production Company

Lease Name Welch "C" Well No. 1

Office Address P. O. Box 351 Liberal, Kansas

Character of Well (completed as Oil, Gas or Dry Hole) Dry Hole

Date well completed 4/28 19 67

Application for plugging filed 4/28 19 67

Application for plugging approved 4/28 19 67


Plugging commenced 4/28 19 67

Plugging completed 4/28 19 67

Reason for abandonment of well or producing formation Dry Hole

If a producing well is abandoned, date of last production 19

Was permission obtained from the Conservation Division or its agents before plugging was commenced? Yes

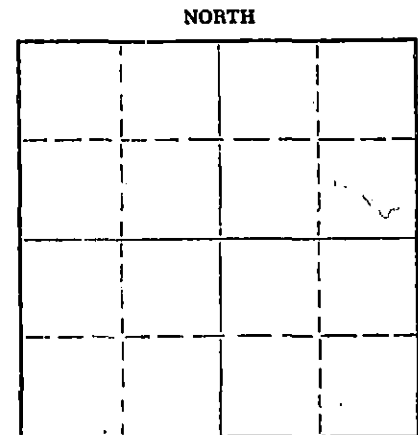

Locate well correctly on above Section Plat

Name of Conservation Agent who supervised plugging of this well Ed Eves Sublette, Kansas 67877

Producing formation Depth to top Bottom Total Depth of Well 5395 Feet

Show depth and thickness of all water, oil and gas formations.

OIL, GAS OR WATER RECORDS

CASING RECORD

FORMATION	CONTENT	FROM	TO	SIZE	PUT IN	PULLED OUT
				8-5/8	1365	None

Describe in detail the manner in which the well was plugged, indicating where the mud fluid was placed and the method or methods used in introducing it into the hole. If cement or other plugs were used, state the character of same and depth placed, from feet to feet for each plug set.

Laid down drill pipe to 700'. Spotted 35 sacks cement from 700' to 600'.

Laid down drill pipe. Filled hole with mud to 45'.

Spotted 15 sacks cement from 45' to 0'.

Plugged rat & mouse hole with 5 sacks of cement.

Completed @ 4:30 p.m. 4/28/67.

FILED  
MAY 9 1967  
STATE CORPORATION COMMISSION  
CONSERVATION DIVISION  
Wichita, Kansas

(If additional description is necessary, use BACK of this sheet)

Name of Plugging Contractor Lohmann - Johnson Drilling Company, Inc.

Address 1737 Wichita Plaza Building, Wichita, Kansas 67202

STATE OF Kansas, COUNTY OF Seward, ss.

V. K. Downey (employee of owner) or (owner) of the above-described

well, being first duly sworn on oath, says: That I have knowledge of the facts, statements, and matters herein contained and the log of the above-described well as filed and that the same are true and correct. So help me God

V. K. Downey, Superintendent (Signature)

Liberal Production Region P. O. Box 351 Liberal, Kansas 67901

(Address)

SUBSCRIBED AND SWORN to before me this 3rd day of May, 19 67

My Commission Expires June 28, 1967.

Kennie L. Jackson Notary Public.

My commission expires

DRILLER'S LOG

WELL NAME: Welch "C" No. 1 ; COMPANY OPERATING: Anadarko Production Company

ADDRESS of COMPANY: Box 351 Liberal, Kansas

WELL LOCATION: 1/2 NE 1/4 NE 1/4,  
4788 ft. North of South line,  
4626 ft. East of West line; Sec. 13, Twp. 34S, Rge. 42W, Morton County, Kansas

DRILLING STARTED 4/14, 1967; DRILLING COMPLETED 4/28, 1967

WELL COMPLETED \_\_\_\_\_, 19\_\_\_\_; WELL CONNECTED \_\_\_\_\_, 19\_\_\_\_

ELEVATION: 3440.3 ft. Ground Level; CHARACTER OF WELL (Oil, Gas, or Dry Hole) Dry Hole

OIL OR GAS SANDS OR ZONES - PERFORATIONS - ACIDIZING AND FRACTURING INFORMATION					
Name	From	To	No. of Shots	Gallons Used	Kind Used

CASING RECORD

Size	Amount Set	Sacks of Cement	Amount Pulled
<u>8-5/8"</u>	<u>1365'</u>	<u>700</u>	<u>None</u>

FORMATION RECORD

Formation	Top	Bottom	Formation	Top	Bottom
Surface Sand	0	755	Shale & Lime	4559	4808
Gyp - Red Bed & Shells	755	1366	Lime & Sand	4808	5036
Anhydrite	1366	1370	Lime	5036	5395
Shales & Red Bed	1370	2317	Rotary Total Depth		5395
Shale	2317	2570			
Lime	2570	2730			
Shale & Lime	2730	2842			
Lime	2842	3213			
Lime - Shale w/Chert	3213	3408			
Lime	3408	3700			
Lime w/Sand	3700	3797			
Lime & Sand	3797	4025			
Lime	4025	4559			

MAY 9 1967  
 CONSERVATION DIVISION  
 WICHITA, KANSAS

RESULTS of INITIAL PRODUCTION TEST: Plugged 4/28/67