

SIDE ONE

STATE CORPORATION COMMISSION OF KANSAS
OIL & GAS CONSERVATION DIVISION
WELL COMPLETION OR RECOMPLETION FORM
ACO-1 WELL HISTORY
DESCRIPTION OF WELL AND LEASE

API NO. 15-..... 007-22233-00-00
County..... Barber
..... E 1/2 NW Sec. 16 Twp. 35S Rge. 13 East
..... X West

Operator: License # 5171
Name TXO Production Corp.
Address 1660 Lincoln Street
Suite 1800
City/State/Zip Denver, CO 80264

..... 1430 Ft North from Southeast Corner of Section
..... 3280 Ft West from Southeast Corner of Section
(Note: Locate well in section plat below)

Purchaser.....

Lease Name..... Bar Boot Ranch Well #..... 1
Field Name..... Aetna


Operator Contact Person Les K. Smith
Phone 303-861-4246

Producing Formation.....
Elevation: Ground..... 1580 KB..... 1593

Contractor: License # 5380
Name Eagle Drilling Inc.

Wellsite Geologist..... Ken LeBlanc
Phone..... 316-683-8145

Designate Type of Completion
 New Well Re-Entry Workover
 Oil SWD Temp Abd
 Gas Inj Delayed Comp.
 Dry Other (Core, Water Supply State)

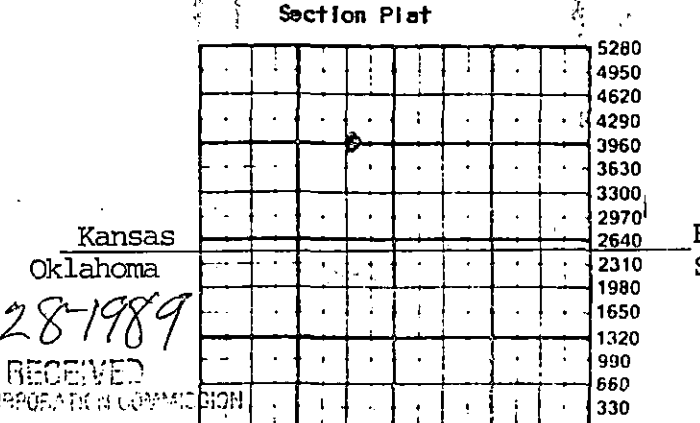

If O.W.O.: old well info as follows:
Operator.....
Well Name.....
Comp. Date..... Old Total Depth.....

CONSERVATION DIVISION WATER SUPPLY INFORMATION
Disposition of Produced Water: Disposal
 Repressuring
Docket #.....

WELL HISTORY

Drilling Method:
 Mud Rotary Air Rotary Cable

03-24-89..... 04-01-89..... 04-01-89.....
Spud Date Date Reached TD Completion Date
5300'
Total Depth PBD

Amount of Surface Pipe Set and Cemented at 404 feet
Multiple Stage Cementing Collar Used? Yes No
If yes, show depth set.....feet
If alternate 2 completion, cement circulated
from.....feet depth to.....w/.....SX cmt
Cement Company Name.....
Invoice #.....

INSTRUCTIONS: This form shall be completed in triplicate and filed with the Kansas Corporation Commission, 200 Colorado Derby Building, Wichita, Kansas 67202, within 120 days of the spud date of any well. Rule 82-3-130, 82-3-107 and 82-3-106 apply.
Information on side two of this form will be held confidential for a period of 12 months if requested in writing and submitted with the form. See rule 82-3-107 for confidentiality in excess of 12 months.
One copy of all wireline logs and drillers time log shall be attached with this form. Submit CP-4 form with all plugged wells. Submit CP-111 form with all temporarily abandoned wells.

All requirements of the statutes, rules and regulations promulgated to regulate the oil and gas industry have been fully complied with and the statements herein are complete and correct to the best of my knowledge.

Signature Les K. Smith
Title..... Engineer Date..... 6/22/89

Subscribed and sworn to before me this 22 day of June 1989.
Notary Public..... Char Stecki
Date Commission Expires..... Feb 8, 1993

K.C.C. OFFICE USE ONLY
 Letter of Confidentiality Attached
 Wireline Log Received
 Drillers Time Log Received
Distribution
 KCC SWD/Rep NGPA
 KGS Plug Other
(Specify)
6-28-89 X

Sec. 16 Twp. 35Rge. 13W