

SIDE ONE

Two (2) copies of this form shall be filed with the Kansas Corporation Commission, 200 Colorado Derby Building, Wichita, Kansas 67202, within thirty (30) days after the completion of a well, regardless of how the well was completed.

Attach separate letter of request if the information is to be held confidential. If confidential, only file one copy. Information on Side One will be of public record and Side Two will then be held confidential.

Applications must be made on dual completion, commingling, salt water disposal, injection and temporarily abandoned wells.

Attach one copy only wireline logs (i.e. electrical log, sonic log, gamma ray neutron log, etc.). (Rules 82-2-105 & 82-2-125) KCC# (316) 263-3238.

LICENSE # 5035 EXPIRATION DATE 6/30/83

OPERATOR ALADDIN PETROLEUM CORPORATION API NO. 15-191-21,417-0000

ADDRESS 809 Petroleum Building COUNTY Sumner

Wichita, KS 67202 FIELD Anson, (KC-Miss)

\*\* CONTACT PERSON James Carpenter PROD. FORMATION Mississippi

PHONE 316-265-9602

PURCHASER Derby Refining Company LEASE AUFDERHAR

ADDRESS P. O. Box 1030 WELL NO. 1

Wichita, KS 67201 WELL LOCATION NE SE SW

DRILLING R.R.A., Inc. 990 Ft. from South Line and

CONTRACTOR CONTRACTOR 330 Ft. from East Line of

ADDRESS 510 Hardage Center the SW (Qtr.) SEC 36 TWP 30S RGE 2W.


Wichita, KS 67202

PLUGGING CONTRACTOR

ADDRESS

WELL PLAT

(Office Use Only)

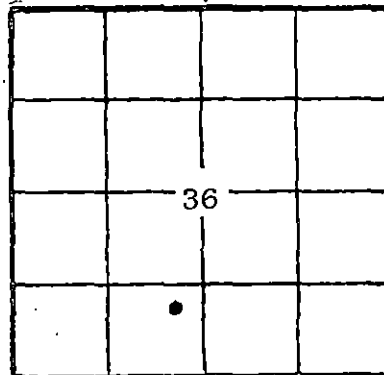

KCC [checked] KGS [checked] SWD/REP PLG.

TOTAL DEPTH 3840 PBD

SPUD DATE 5/11/82 DATE COMPLETED 6/24/82

ELEV: GR 1323 DF KB 1330

DRILLED WITH ~~XXXX~~ (ROTARY) ~~XXXX~~ TOOLS.

DOCKET NO. OF DISPOSAL OR REPRESSURING WELL BEING USED TO DISPOSE OF WATER FROM THIS LEASE

Amount of surface pipe set and cemented 482 DV Tool Used? No

THIS AFFIDAVIT APPLIES TO: (Circle ONE) Oil Gas, Shut-in Gas, Dry, Disposal, Injection, Temporarily Abandoned, OWWO. Other

ALL REQUIREMENTS OF THE STATUTES, RULES AND REGULATIONS PROMULGATED TO REGULATE THE OIL AND GAS INDUSTRY HAVE BEEN FULLY COMPLIED WITH.

A F F I D A V I T

JAMES CARPENTER, being of lawful age, hereby certifies that:

I am the Affiant, and I am familiar with the contents of the foregoing Affidavit. The statements and allegations contained therein are true and correct.

ALADDIN PETROLEUM CORPORATION By James Carpenter (Name)

JAMES CARPENTER, Prod. Supt.


SUBSCRIBED AND SWORN TO BEFORE ME this 19th day of August

19 82.

Leann K. Sharp (NOTARY PUBLIC)

Leann K. Sharp

MY COMMISSION EXPIRES:

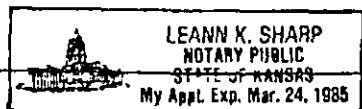

RECEIVED

\*\* The person who can be reached by phone regarding any questions concerning this information.

AUG 23 1982

CONSERVATION DIVISION Wichita, Kansas

FILL IN WELL LOG AS REQUIRED:

Show all important zones of porosity and contents thereof; cored intervals, and all drill-stem tests, including depth interval tested, cushion used, time tool open, flowing and shut-in pressures, and recoveries.			SHOW GEOLOGICAL MARKERS LOGS RUN, OR OTHER DESCRIPTIVE INFORMATION.	
FORMATION DESCRIPTION, CONTENTS, ETC.	TOP	BOTTOM	NAME	DEPTH
No Drill Stem Tests No Cores  Gamma Neutron Log Primary Log			Topeka Heebner Lan-K.C. Marmaton Cherokee Miss. Chat Miss. Lm. Miss. Dol.	2044 2459 3087 3392 3576 3736 3744 3751

Report of all strings set— surface, intermediates, production, etc. **CASING RECORD** (New) or ~~Used~~

Purpose of string	Size hole drilled	Size casing set (in O.D.)	Weight lbs/ft.	Setting depth	Type cement	Sacks	Type and percent additives
Surface	12½"	8-5/8"	24#	482	Com C1"A"	315	3% cc & 2% gel
Production	7-7/8"	4-1/2"	9.5#	3838	50/50 Poz	250	18% salt

**LINER RECORD**

**PERFORATION RECORD**

Top, ft.	Bottom, ft.	Sacks cement	Shots per ft.	Size & type	Depth interval
			4	SSB	3746-60

<b>TUBING RECORD</b>		
Size	Setting depth	Pecker set at
2-3/8"	3774'	None

**ACID, FRACTURE, SHOT, CEMENT SQUEEZE RECORD**

Amount and kind of material used	Depth interval treated
500 gal MCA 15%	

Date of first production 7/21/82	Producing method (flowing, pumping, gas lift, etc.)	Gravity 44
RATE OF PRODUCTION PER 24 HOURS	OH 2 bbls.	Gas MCF 86 % 14 bbls.
Disposition of gas (vented, used on lease or sold)		Perforations 3746-60