

STATE CORPORATION COMMISSION OF KANSAS
OIL & GAS CONSERVATION DIVISION

WELL COMPLETION OR RECOMPLETION FORM
ACO-1 WELL HISTORY

DESCRIPTION OF WELL AND LEASE


Operator: License # 7344
Name Clyde M. Becker
Address 212 First National Bank Bldg.
City/State/Zip Ponca City, OK 74601
Purchaser Mobil (via Permian)
Operator Contact Person Doug Brown
Phone 316-442-4514
Contractor: License # 5382
Name Cheyenne Drilling Co.
Wellsite Geologist Clyde M. Becker, Jr.
Phone 303-595-4045

Designate Type of Completion
 New Well Re-Entry Workover
 Oil SWD Temp Abd
 Gas Inj Delayed Comp.
 Dry Other (Core, Water Supply etc.)
If OWHO: old well info as follows:
Operator
Well Name
Comp. Date Old Total Depth

WELL HISTORY

Drilling Method:
 Mud Rotary Air Rotary Cable
11-17-85 11-29-85 1-14-86
Spud Date Date Reached TD Completion Date
5760 5732
Total Depth PBD
Amount of Surface Pipe Set and Cemented at 1736 feet
Multiple Stage Cementing Collar Used? Yes No
If yes, show depth set 1736 feet
If alternate 2 completion, cement circulated
from 1736 feet depth to Surface, 900 SX cmt

API NO. 15-175-20886-600
County Seward
E/2 NW/4 Sec. 19 Twp. 31 Rge. 34 East West
3770 Ft North from Southeast Corner of Section
3300 Ft West from Southeast Corner of Section
(Note: Locate well in section plat below)
Lease Name Ross Well # 1
Field Name Wildcat Cutter, South
Producing Formation Mississippian
Elevation: Ground 2870 KB 2882
Section Plat

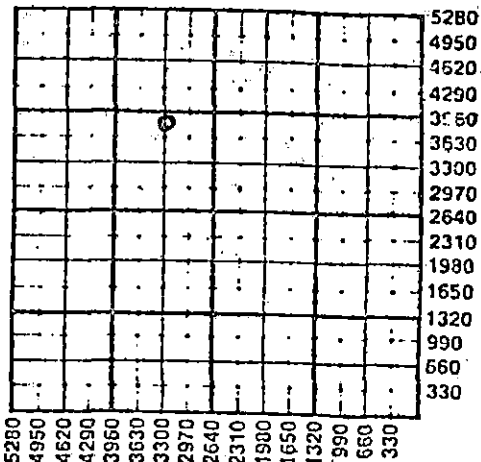

WATER SUPPLY INFORMATION

Disposition of Produced Water: Disposal Reoppressuring
Docket #

Questions on this portion of the ACO-1 call:
Water Resources Board (915) 296-3717

Source of Water:
Division of Water Resources Permit #
 Groundwater.....Ft North from Southeast Corner
(Well)Ft West from Southeast Corner of
Sec Twp Rge East West
 Surface Water 3770 Ft North from Southeast Corner
(Stream, pond etc) 3300 Ft West from Southeast Corner
Sec 19 Twp 31 Rge 34 East West
 Other (explain).....
(purchased from city, R.W.D. #)

INSTRUCTIONS: This form shall be completed in duplicate and filed with the Kansas Corporation Commission, 200 Colorado Derby Building, Wichita, Kansas 67202, within 90 days after completion or recompletion of any well. Rule 82-3-130 and 82-3-107 apply.

Information on side two of this form will be held confidential for a period of 12 months if requested in writing and submitted with the form. See rule 82-3-107 for confidentiality in excess of 12 months. One copy of all wireline logs and drillers time log shall be attached with this form. Submit CP-4 form with all plugged wells. Submit CP-111 form with all temporarily abandoned wells.

All requirements of the statutes, rules and regulations promulgated to regulate the oil and gas industry have been fully complied with and the statements herein are complete and correct to the best of my knowledge.

Signature Clyde M. Becker
Title Operator Date 1-15-86

Subscribed and sworn to before me this 15th day of January 1986

Notary Public Marlene Holmes

Date Commission Expires 11-14-88

K.C.C. OFFICE USE ONLY
 Letter of Confidentiality Attached
 Wireline Log Received
 Drillers Time Log Received
Distribution
 KCC SWD/Rep NGPA
 KGS Plug Other
(Specify)

Sec 19, Twp 31, Rge 34