

9-21-62

15-007-01496-00-00


Give All Information Completely
Make Required Affidavit
Mail or Deliver Report to:
Conservation Division
State Corporation Commission
211 No. Broadway
Wichita, Kansas

WELL PLUGGING RECORD

Barber County, Sec. 15 Twp. 21S Rge. 13W (E) (W)

Location as "NE/CNW%SW%" or footage from lines 125' South C-SW-SW
Lease Owner Sunray DX Oil Company
Lease Name C. Smith "A" Well No. 1
Office Address 321 West Douglas, Wichita 2, Kansas
Character of Well (completed as Oil, Gas or Dry Hole) Dry Hole
Date well completed 19 62
Application for plugging filed September 17, 19 62
Application for plugging approved September 18, 19 62
Plugging commenced September 16, 19 62
Plugging completed September 16, 19 62
Reason for abandonment of well or producing formation Non-Commerical

NORTH

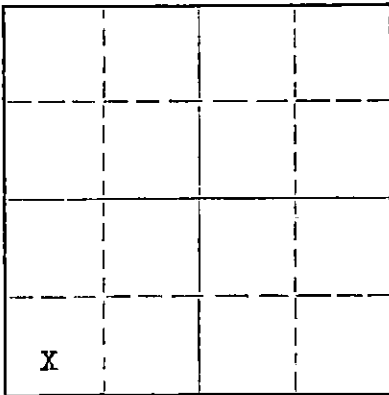

Locate well correctly on above Section Plat

If a producing well is abandoned, date of last production 19
Was permission obtained from the Conservation Division or its agents before plugging was commenced? Yes

Name of Conservation Agent who supervised plugging of this well Herman Justus, Box 71, Nickerson, Kansas
Producing formation Depth to top Bottom Total Depth of Well 4700 Feet
Show depth and thickness of all water, oil and gas formations.

OIL, GAS OR WATER RECORDS

CASING RECORD

FORMATION	CONTENT	FROM	TO	SIZE	PUT IN	PULLED OUT
Massey	Water	4234'	4269'	13 3/8"	289'	-0-
Mississippi	Water	4283'	4301'			
Simpson	Water	4565'	4584'			
Viola	Water	4490'	4544'			
Kinderhook	Water	4412'	4490'			
Arbuckle	Water	4641'	TD			

Describe in detail the manner in which the well was plugged, indicating where the mud fluid was placed and the method or methods used in introducing it into the hole. If cement or other plugs were used, state the character of same and depth placed, from feet to feet for each plug set.

Filled hole with mud from 4700' to 250' and set 25 Sacks of cement. Filled hole with mud to 35' and set 25 sacks of cement to surface and cap well.

RECEIVED
STATE CORPORATION COMMISSION

SEP 21 1962

CONSERVATION DIVISION
Wichita, Kansas

(If additional description is necessary, use BACK of this sheet)

Name of Plugging Contractor Stickle Drilling Company
Address 1100 Bitting Building, Wichita, Kansas

STATE OF Kansas, COUNTY OF Sedgwick, ss.
Gary W. Pierce (employee of owner) or (owner or operator) of the above-described well, being first duly sworn on oath, says: That I have knowledge of the facts, statements, and matters herein contained and the log of the above-described well as filed and that the same are true and correct. So help me God.

(Signature) Gary W. Pierce
321 West Douglas, Wichita 2, Kansas
(Address)

SUBSCRIBED AND SWORN TO before me this 20th day of September, 19 62

My commission expires July 13, 1963

[Signature]
Notary Public.

623-19

Sunray DX Oil Company
Tulsa, Oklahoma

Tulsa, Oklahoma
September 18, 1962

Contractor: Stickle Drilling Company
Date Commenced: August 31, 1962
Date Completed: September 16, 1962

Chas. W. Smith "A" No. 1
Ctr. SW SW Section 15-31S-13W
Barber County, Kansas

15-607-81496-0002

DRILLER'S LOG

Depth Figures Indicate Base of Formation:

Red shale	135
Red bed	1111
Shale	1795
Shale and lime	1945
Lime and shale	2125
Shale and lime	2280
Lime and shale	2472
Shale and lime	2631
Shale and chalk	2842
Lime and shale	2975
Shale and lime	3415
Lime and shale	3560
Shale and lime	3828
Lime and shale	3950
Lime	4301
Chert and lime	4561
Shale and sand	4570
Sand and shale	4698
Shale	4644
Shale and lime	4700 TD


RECEIVED
STATE CORPORATION COMMISSION

SEP 21 1962

CONSERVATION DIVISION
Wichita, Kansas

I, Fred E. Stickle, hereby certify the above to be a true and complete Driller's Log of Sunray DX Oil Company's Chas. W. Smith "A" No. 1, Center of SW/4 SW/4 of Section 15-31S-13W., Barber County, Kansas.


FRED E. STICKLE


Notary Public

My Commission expires March 24, 1964