


1-31-63

WELL PLUGGING RECORD 15-607-0497-0000

Give All Information Completely
Make Required Affidavit
Mail or Deliver Report to:
Conservation Division
State Corporation Commission
211 No. Broadway
Wichita, Kansas

NORTH

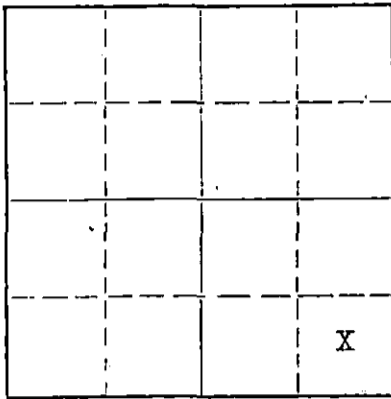

Locate well correctly on above
Section Plat

Barber County, Sec. 16 Twp. 31S Rge. 13W (E) (W)
Location as "NE/CNW/SW" or footage from lines C-SE-SE
Lease Owner Sunray DX Oil Company
Lease Name Charles Smith "B" Well No. 1
Office Address 321 West Douglas, Wichita 2, Kansas
Character of Well (completed as Oil, Gas or Dry Hole) Dry Hole
Date well completed 19
Application for plugging filed January 18, 19 63
Application for plugging approved January 21, 19 63
Plugging commenced January 18, 19 63
Plugging completed January 18, 19 63
Reason for abandonment of well or producing formation Non-Commercial

If a producing well is abandoned, date of last production 19
Was permission obtained from the Conservation Division or its agents before plugging was commenced? Yes

Name of Conservation Agent who supervised plugging of this well Archie Elving, Box 652, Pratt, Kansas
Producing formation Depth to top Bottom Total Depth of Well 4564 Feet
Show depth and thickness of all water, oil and gas formations.

OIL, GAS OR WATER RECORDS

CASING RECORD

FORMATION	CONTENT	FROM	TO	SIZE	PUT IN	PULLED OUT
Mississippi	Dry	4260'	4280'	13 3/8"	288'	0'
Simpson	Dry	4510'	4538'			

Describe in detail the manner in which the well was plugged, indicating where the mud fluid was placed and the method or methods used in introducing it into the hole. If cement or other plugs were used, state the character of same and depth placed, from _____ feet to _____ feet for each plug set.
Filled hole with mud from total depth to 180' and set plug with 20 sacks of cement. Filled to 40' with mud and set plug with 10 sacks of cement to surface and cap well.

RECEIVED
STATE CORPORATION COMMISSION
JAN 31 1963
CONSERVATION DIV.
WICHITA, KANSAS

(If additional description is necessary, use BACK of this sheet)
Name of Plugging Contractor Stickle Drilling Company
Address 1100 Bitting Building, Wichita, Kansas

STATE OF Kansas, COUNTY OF Sedgwick, ss.
Gary W. Pierce (employee of owner) or (owner/operator) of the above-described well, being first duly sworn on oath, says: That I have knowledge of the facts, statements, and matters herein contained and the log of the above-described well as filed and that the same are true and correct. So help me God.
(Signature) Gary W. Pierce
321 West Douglas, Wichita 2, Kansas (Address)

SUBSCRIBED AND SWORN TO before me this 30th day of January, 1963
My commission expires July 13, 1963
Notary Public.



Sunray DX Oil Company
Tulsa, Oklahoma

Tulsa, Oklahoma
January 21, 1963

Contractor: Stickle Drilling Company
Date Commenced: January 4, 1963
Date Completed: January 18, 1963

Charles Smith "B" No. 1
SE SE Sec. 16-31S-13W
Barber County, Kansas

DRILLERS LOG

15-007-01497-0000

Depth Figures Indicate Base of Formation:

Red bed	100
Red bed and shells	750
Red bed and shale	1145
Shale and shells	1870
Shale and lime	2070
Lime	2265
Lime and shale	2621
Shale and lime	3227
Lime and shale	3670
Shale and lime	3780
Lime and shale	3860
Lime	4180
Lime and shale	4270
Lime	4295
Chert and lime	4460
Lime and chert	4510
Shale and sand	4530
Sandy shale and lime	4564 TD

RECEIVED
STATE CORPORATION COMMISSION

JAN 31 1963

CONSERVATION DIVISION

I, Fred E. Stickle, hereby certify the above to be a true and complete Driller's Log of Sunray DX Oil Company's Charles Smith "B" No. 1, SE SE Section 16-31S-13 W., Barber County, Kansas.

Fred E. Stickle
FRED E. STICKLE

Mary E. Brown
Notary Public

August 18, 1965
My Commission expires