

2-4-82

RECEIVED  
 STATE CORPORATION COMMISSION


15-007-21124-000 FEB - 4 1982

WELL PLUGGING RECORD

Give All Information Completely  
 Make Required Affidavit

COUNTY Barber SEC. 13 TWP. Wichita  
 Location as in quarters or footage from lines:  
C E 1/2

CONSERVATION DIVISION  
 WICHITA, KANSAS

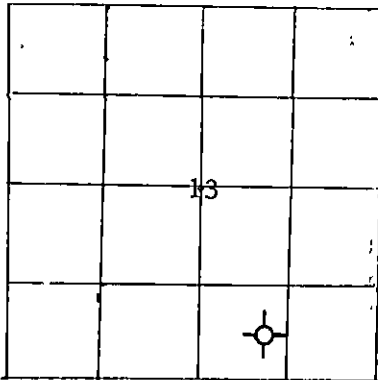

Locate Well  
 correctly on above  
 Section Platt.

Lease Owner Wild Boys & The Silver Bullet  
 Lease Name FISTFULL OF DOLLARS Well No. 1  
 Office Address 815 N. Waco, Suite 3A, Wichita, Ks.  
 Character of Well (Completed as Oil, Gas or Dry Hole): Dry Hole  
 Date Well Completed 4-16-81  
 Application for plugging filed February 3, 1982 ✓  
 Plugging commenced 4-16-81 2:30 p.m.  
 Plugging completed 4-16-81 3:45 p.m.  
 Reason for abandonment of well or producing formation Non-Commercial

Was permission obtained from the Conservation Division or it's  
 Agent's before plugging was commenced? Yes

Name of Conservation Agent who supervised plugging of this well Maurice Leslie ✓  
 Producing formation N/A Depth to top \_\_\_\_\_ bottom T.D. 4707'

Show depth and thickness of all water, oil and gas formations.

OIL, GAS OR WATER RECORDS

Casing Record

Formation	Content	From	To	Size	Put in	Pulled Out
Heebner		3618		13 3/8"	75	
Lansing		3786		8 5/8"	769	
B/KC		4186				
Mississippi		4283				
Arbuckle		4638				

Describe in detail the manner in which the well was plugged, indicating where the mud fluid was placed and the method or methods used in introducing it into the hold. If cement or other plugs were used, state the character of same and depth placed, from \_\_\_\_\_ feet to \_\_\_\_\_ feet for each plug set.

50 sx at 800', 30 sx at 400', bridge plug and 10 sx cement at 40'. 5 sx in Rathole and Mousehole. Common cement + 3% Gel pumped into place. Cement plugs from 800' to 660', 400' to 315'. Wooden bridge plug at 40' and cement to surface. Mud fluids are left in pits and backfilled in place when sufficiently dry.

(If additional description is necessary, use BACK of this sheet)

Name of Plugging Contractor Sun Oilwell Cementing

STATE OF Kansas COUNTY OF Sedgwick, ss.  
R. A. Christensen (employee of owner) or (~~owner or operator~~) of the above-described well, being first duly sworn on oath, says: That I have knowledge of the facts, statements, and matters herein contained and the log of the above-described well as filed and that the same are true and correct. So help me God.

(Signature) R.A. Christensen

(Address)

SUBSCRIBED AND SWORN TO before me this 3<sup>rd</sup> day of February, 19 82

Alonso De Ar

Notary Public.

My Commission expires: October 29, 1982

DONNA HALE 120  
 STATE NOTARY PUBLIC  
 SEDGWICK COUNTY, KANSAS