


Give All Information Completely
Make Required Affidavit
Mail or Deliver Report to:
Conservation Division
State Corporation Commission
800 Bittig Building
Wichita, Kansas

7-24-54

WELL PLUGGING RECORD

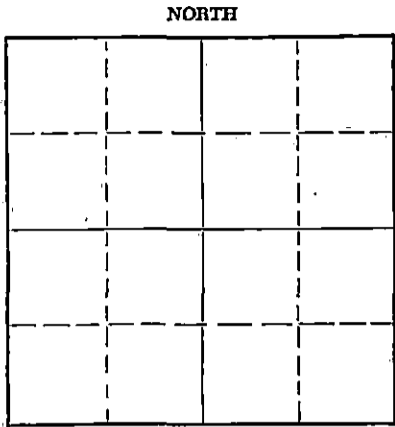

Locate well correctly on above Section Plat

Barber County, Sec. 18 Twp. 31 Rge. 13 (E) (W)
Location as "NE/CNW%SW%" or footage from lines SE SE NW
Lease Owner Aylward Drilling Company et al
Lease Name Gant Well No. 1
Office Address 813 1st Natl. Bank Bldg., Wichita, Kansas
Character of Well (completed as Oil, Gas or Dry Hole) Dry Hole
Date well completed July 19 19 54
Application for plugging filed July 19 19 54
Application for plugging approved July 19 19 54
Plugging commenced July 19 19 54
Plugging completed July 19 19 54
Reason for abandonment of well or producing formation _____

If a producing well is abandoned, date of last production 19 _____
Was permission obtained from the Conservation Division or its agents before plugging was commenced? Yes

Name of Conservation Agent who supervised plugging of this well Mr. M. A. Rives - Pratt, Kansas
Producing formation _____ Depth to top _____ Bottom _____ Total Depth of Well _____ Feet
Show depth and thickness of all water, oil and gas formations.

OIL, GAS OR WATER RECORDS

CASING RECORD

FORMATION	CONTENT	FROM	TO	SIZE	PUT IN	PULLED OUT
				8 5/8"	104'	None

Describe in detail the manner in which the well was plugged, indicating where the mud fluid was placed and the method or methods used in introducing it into the hole. If cement or other plugs were used, state the character of same and depth placed, from _____ feet to _____ feet for each plug set.
Heavy mud 4317' to 110' - wooden plug at 110' - 1/3 sack of hulls and cement plug of 20 sacks; heavy mud 60' to 30' - top plug from 30' to top of surface pipe with 1/3 sack of hulls and 10 sacks of cement.

RECEIVED
STATE CORPORATION COMMISSION
JUL 24 1954
CONSERVATION DIVISION
Wichita, Kansas

(If additional description is necessary, use BACK of this sheet)
Name of Plugging Contractor Aylward Drilling Company - 813 1st Natl. Bank Bldg.
Address Wichita, Kansas

STATE OF KANSAS, COUNTY OF SEDGWICK, ss.
Paul W. Hesse (employee of owner) or (owner or operator) of the above-described well, being first duly sworn on oath, says: That I have knowledge of the facts, statements, and matters herein contained and the log of the above-described well as filed and that the same are true and correct. So help me God.

(Signature) Paul W. Hesse
813 1st Natl. Bank Bldg., Wichita, Kans.
(Address)

SUBSCRIBED AND SWORN to before me this 21st day of July, 1954

My commission expires December 11, 1957

Duane Jessup
Notary Public.

24-7366-6 3-53-20M
PLUGGING
FILED SEC 18 T 31 R 13W
BOOK PAGE 49 LINE 24

DRILLERS LOG

15-007-00566-0000

GANT #1

Casing Record:
8-5/8 @ 104

Company: Aylward Drilling Company et al
Contractor: Aylward Drilling Company

Location:
SE SE NW
Sec. 18-31-13W.
Barber County, Kans.
Elevation: 1663 R.B.

Commenced: July 7, 1954
Completed: July 19, 1954

	From	To	REMARKS
Gravel and dirt	0	30	
Lime	30	60	
Red beds and shale	60	104	
Red bed	104	245	
Red bed and shale	245	635	
Anhydrite	635	675	
Shale and shells	675	1360	DST #1 4216-42 Open 1 hour. Recovered 55' Mud BHP 0#
Salt	1360	1420	
Shells	1420	1435	
Shale, lime and sand	1435	1735	
Lime and shale	1735	3262	
Lime	3262	3430	
Lime and shale	3430	3537	
Sandy lime	3537	3610	
Lime	3610	3710	
Lime and sand	3710	3760	
Lime	3760	4277	
Lime and chat	4277	4317 T. D.	

GEOLOGICAL TOPS:

Douglas Sand	3741
Lansing	3784
Massey Zone	4232
Mississippian	4290
R. T. D.	4317

RECEIVED
STATE CORPORATION COMMISSION
JUL 24 1954
CONSERVATION DIVISION
Wichita, Kansas

I certify that this is a true and correct copy of the above log to the best of my knowledge.

Paul W. Hesse
Paul W. Hesse

Subscribed and sworn to before me this 22nd day of July, 1954

Duane Jessup
Notary Public

My Commission Expires: December 11, 1957

PLUGGING
FILE SEC 18 T 31 R 13W
BOOK PAGE 49 LINE 24