


Give All Information Completely
Make Required Affidavit
Mail or Deliver Report to:
Conservation Division
State Corporation Commission
800 Bittling Building
Wichita, Kansas

10-21-42
WELL PLUGGING RECORD
OR
FORMATION PLUGGING RECORD

Strike out upper line
when reporting plug-
ging off formations.

NORTH

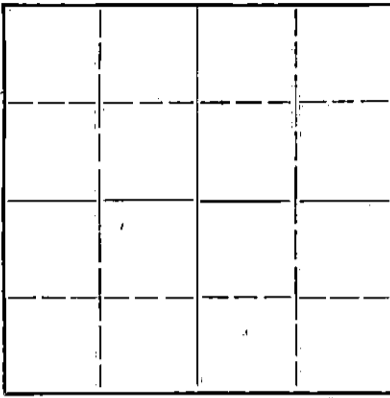

Locate well correctly on above
Section Plat

Barber County, Sec. 18, Twp. 31, Rge. 13 (E) 13 (W)
Location as "NE 1/4 NW 1/4 SW 1/4" or footage from lines C. W. 1/2
Lease Owner Pryor & Lockhart Inc.
Lease Name Vanderplas Well No. 1
Office Address 820 Union Natl Bank Bldg.
Character of Well (completed as Oil, Gas or Dry Hole) Dry Hole
Date well completed September 26th, 1942
Application for plugging filed September 26th, 1942
Application for plugging approved September 26th, 1942
Plugging commenced September 27th, 1942
Plugging completed October 2nd, 1942
Reason for abandonment of well or producing formation Dry Hole
If a producing well is abandoned, date of last production 19
Was permission obtained from the Conservation Division or its agents before plugging was commenced? Yes.

Name of Conservation Agent who supervised plugging of this well C. T. Alexander
Producing formation Depth to top Bottom Total Depth of Well 4316 Feet
Show depth and thickness of all water, oil and gas formations.

OIL, GAS OR WATER RECORDS

CASING RECORD

Formation	Content	From	To	Size	Put In	Pulled Out
				12"	171	None
				5 1/2"	4354	4110

Describe in detail the manner in which the well was plugged, indicating where the mud fluid was placed and the method or methods used in introducing it into the hold. If cement or other plugs were used, state the character of same and depth placed, from feet to feet for each plug set.

Hole Filled from 4316ft. to 4296 with Chat and cement then mud to 180ft.
Then permanent bridge at 180ft. then cement to 165ft. then mud to 26ft. then
cement to 6 ft. and mud to top of surface.

PLUGGING
FILE SEC. 16 31 R. 13 W.
BOOK PAGE 51 NE 1

(If additional description is necessary, use BACK of this sheet)


Correspondence regarding this well should be addressed to Pryor & Lockhart Inc.
Address 820 Union Natl Bank Bldg. Wichita, Kansas.

STATE OF Kansas, COUNTY OF Sedgwick, ss.
(employee of owner) or (owner or operator) of the above-described well,
being first duly sworn on oath, says: That I have knowledge of the facts, statements, and matters herein contained and the log of the above-described well as filed and that the same are true and correct. So help me God.

(Signature) J. P. Hendrick
820 Union Natl Bank Bldg. Wichita, Kansas.
(Address)

SUBSCRIBED AND SWORN to before me this 14 day of October

My commission expires Feb 20, 1945

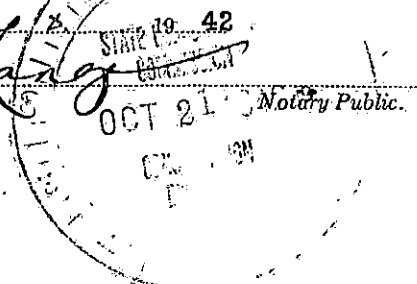

15-007-10070-00-0

PRYOR & LOCKHART, INC. ET AL
 Vanderplas No. 1.

SEC. 18 T. 31 R. 13W
 NW 1/4 SE
 Approx. 440'S 495'E NW 1/4 SE 1/4

Total Depth. 4620'
 Comm. 12-28-39 Comp. 3-2-40
 Shot or Treated.
 Contractor. Pryor & Lockhart, Inc.
 Issued. 3-16-40

County. Barber



CASING:
 13" 171'

Elevation.

Production. Dry

Figures Indicate Bottom of Formations.

cellar	11	lime	3910
shale & shells	599	brkn lime & shale brks	3960
shale red	666	lime hrd & sft	4005
shale & shells	929	lime break	4035
shale	1135	lime	4043
shale & shells	1412	lime	4070
shale & salt	1620	lime cherty	4078
lime brkn	1655	lime	4127
shale & lime	1775	shale	4135
lime	1805	lime	4140
shale & lime	1835	shale	4148
shale	1915	lime	4155
lime	1945	shale	4160
shale	1955	lime	4185
lime	1965	shale	4200
shale	1975	lime	4233
lime & shale brks	2015	shale & lime	4261
lime & shale	2049	lime	4267
lime	2055	shale	4275
sand	2080	lime	4288
shale	2134	chat	4305
lime	2200	chat & lime	4315
shale & shells	2206	lime	4339
lime	2225	shale & lime	4377
shale & lime	2278	shale	4393
lime	2350	lime Viola	4412
shale & lime	2500	lime	4443
lime	2525	lime cherty	4466
shale & lime	2616	lime & chert	4477
shale sticky	2652	lime	4493
shale	2660	shale	4498
lime brkn	2690	lime	4518
shale & shells	2735	lime & shale	4535
shale & lime	2800	sand	4552
lime	3168	lime	4555
lime sft	3192	shale	4565
lime	3210	sand	4570
shale	3216	shale	4576
shale & lime	3265	shale sdy	4590
lime sdy	3291	shale	4605
shale sticky	3310	lime	4620
shale & shells	3326	Total Depth.	
shale & lime	3350		
shale	3365	Tops:	
lime	3395	Ft. Riley 2010	
shale	3415	Florence 2120	
lime	3445	Topeka 2845	
shale	3450	Lansing 3765	
lime	3500	Chat 4286	
shale	3512	Kinderhook shale 4340	
lime	3595	Viola 4391	
shale & shells	3616	Simpson 4510	
lime brkn & shale	3648	Arbuckle 4602	
shale	3660		
lime	3665		
shale	3677		
shale & lime	3695		
shale	3714		
sand	3735		
lime	3755		
shale	3760		

Perforation Record:
 Comm. 6-17-42
 Comp. 10-7-42
 Production - Dry
 (Old Dry Hole Perforated to
 test K.C.)
 9-16-42 44 holes 4193 1/2 - 4398
 #8 12 4190-94
 #9 12 4194-98
 #7 12 4192-96
 #6 12 4196-4200
 #5 12 4201-05
 #4 12 4192-99
 #2 5 4195-99
 #3 3 4200-02
 #10 12 4200-06

WELLS LOGGING
 1613 LR 13W
 BOOK PAGE 51 LINE 7

OCT 21 1940