

4-23-80


STATE OF KANSAS
STATE CORPORATION COMMISSION

WELL PLUGGING RECORD

Give All Information Completely
Make Required Affidavit
Mail or Deliver Report to
Conservation Division
State Corporation Comm.
245 North Water
Wichita, KS 67202

Barber County, Sec. 22 Twp. 31S Rge. 13W E/W
Location as "NE/CNW1SW1" or footage from lines
C - NE - SE

Lease Owner Mid-Continent Energy
Lease Name Packard Well No. 1
Office Address 120 Building -#712, Wichita, Kansas 67202
Character of Well (Completed as Oil, Gas or Dry Hole)
Gas

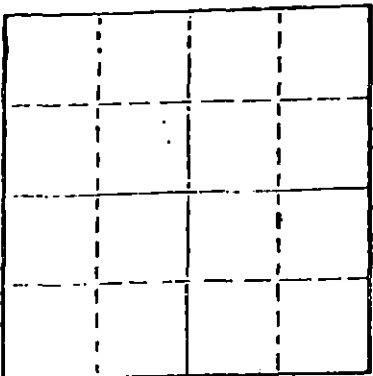

Locate well correctly on above
Section Plot

Date Well completed 19
Application for plugging filed 4-2- 1980
Application for plugging approved 4-2 1980
Plugging commenced 4-7 1980
Plugging completed 4-10 1980
Reason for abandonment of well or producing formation

If a producing well is abandoned, date of last production 19

Was permission obtained from the Conservation Division or its agents before plugging was commenced? Yes
Bill Owens

Name of Conservation Agent who supervised plugging of this well
Producing formation Depth to top Bottom Total Depth of Well 2700
Show depth and thickness of all water, oil and gas formations.

OIL, GAS OR WATER RECORDS CASING RECORD

FORMATION	CONTENT	FROM	TO	SIZE	PUT IN	PULLED OUT
				8 5/8	214	None
				4 1/2	2699	1914

Describe in detail the manner in which the well was plugged, indicating where the mud fluid was placed and the method or methods used in introducing it into the hold. If cement or other plugs were used, state the character of same and depth placed, from feet to feet for each plug set.

Plug back at 2656
Dumped sand 2656 to 2580
4 sacks cement 2580 to 2560
Ripped at 2200 2000 and 1914

Pumped in 8 sacks hull
Pumped in 20 sacks jell
Pumped in 100 sacks 50-50 POZ

RECEIVED
STATE CORPORATION COMMISSION
APR 23 1980
CONSERVATION DIVISION
Wichita, Kansas

(If additional description is necessary, use BACK of this sheet)

Name of Plugging Contractor Clarke Corporation

STATE OF Kansas COUNTY OF Barber, ss.
Elmo Morgenstern (employee of owner) or (owner or operator)
of the above-described well, being first duly sworn on oath, says: That I have knowledge of the facts, statements, and matters herein contained and the log of the above-described well as filed and that the same are true and correct. So help me God.

(Signature) Elmo Morgenstern
Medicine Lodge, Kansas
(Address)

SUBSCRIBED AND SWORN TO before me this 15th day of April, 1980

Jessie Hamilton
Notary Public.

My commission expires April 4, 1982

15-007-20470-00-00

DRILLERS LOG

PACKARD #1

CASING RECORD:
8 5/8" set at 214'
with 175 sacks cement

OPERATOR: Mid-Continent Energy Corp.

DESCRIPTION:

TOTAL DEPTH:
2700'

CONTRACTOR: Search Drilling Company

C NE SE
Section 22-31S-13W
Barber County,
Kansas

COMMENCED: December 18, 1976

COMPLETED: December 22, 1976

<u>FORMATION</u>	<u>FROM</u>	<u>TO</u>	<u>REMARKS</u>
Sand & Gravel	0	28	
Red Bed & Shale	28	220	
Shale and Red Bed	220	1284	
Shale	1284	1712	
Shale and Lime	1712	2349	
Lime and Shale	2349	2677	
Lime and Shale	2677	2700	
Rotary Total Depth	2700		

Ran 82 joints of
new 4 1/2" -10#
K-55 Production pipe
(2689') cemented at 26
with 200 sacks 50-50
posmix, salt saturated
and 10 barrels salt
flush, 3/4# CFR-2.
Plug down at 4:15 P.M.

RECEIVED
STATE CORPORATION COMMISSION

JAN 18 1980

CONSERVATION DIVISION
Wichita, Kansas

I certify that this is a true and correct copy of the above log to the best of my knowledge

SEARCH DRILLING COMPANY

William J. Froelich, Jr.
William J. Froelich, Jr.

Subscribed and sworn to before me this 22th day of December, 1976.

My commission expires:
February 19, 1977

Maxine Dressen
Maxine Dressen Notary Public

MAXINE DRESSEN
NOTARY PUBLIC
SEDCWICK COUNTY, KANSAS
MY COMM. EXP. FEB. 19, 1977