

12-9-76


STATE OF KANSAS
STATE CORPORATION COMMISSION

15-025-20136-0000

WELL PLUGGING RECORD

Give All Information Completely
Make Required Affidavit
Mail or Deliver Report to
Conservation Division
State Corporation Comm.
245 North Water
Wichita, KS 67202

Clark County. Sec. 34 Twp. 31S Rge. 21 E/W
Location as "NE/CNW $\frac{1}{4}$ SW $\frac{1}{4}$ " or footage from lines
410' FWL & 1980' FNL, SW/4 NW/4
Lease Owner Reading & Bates Oil and Gas Co.
Lease Name George Seacat Well No. 1
Office Address 3800 First Place

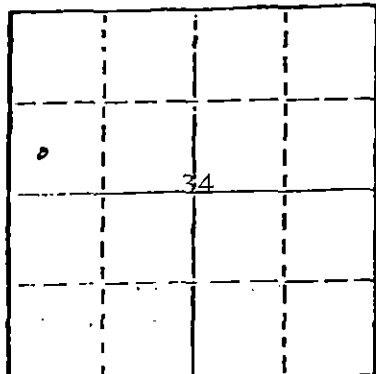

Character of Well (Completed as Oil, Gas or Dry Hole)
Dry Hole

Date Well completed N.C. 19
Application for plugging filed (written) 12-3 1976
Application for plugging approved (verbal) 11-19 1976
Plugging commenced 11-20 1976
Plugging completed 11-21 1976

Reason for abandonment of well or producing formation
No oil and no gas.

If a producing well is abandoned, date of last production
19

Was permission obtained from the Conservation Division or
its agents before plugging was commenced? Yes

Name of Conservation Agent who supervised plugging of this well Clarence Thomas
Producing formation None Depth to top Bottom Total Depth of Well 5234'
Show depth and thickness of all water, oil and gas formations.

OIL, GAS OR WATER RECORDS

CASING RECORD

FORMATION	CONTENT	FROM	TO	SIZE	PUT IN	PULLED OUT
				8-5/8"	664'	None

Describe in detail the manner in which the well was plugged, indicating where the mud fluid was placed and the method or methods used in introducing it into the hold. If cement or other plugs were used, state the character of same and depth placed, from feet to feet for each plug set.

Hole loaded w/9,4# mud w/68 vis., W.L. 11.2
60 sx. Class "H" cmt. plug from 600' to 400'
15 sx. cmt. plug from 40' to top of surface
5 sx. cmt. plug in rat.holes & mouse hole.

STATE CORPORATION COMMISSION

DEC 09 1976

CONSERVATION DIVISION
Wichita, Kansas

(If additional description is necessary, use BACK of this sheet)

Name of Plugging Contractor Halliburton Oil Well Cementing Co. & Gabbert-Jones, Inc.

STATE OF Oklahoma COUNTY OF Tulsa, ss.
Glenn E. Wood (employee of owner) or (owner or operator)
of the above-described well, being first duly sworn on oath, says: That I have knowledge of the facts, statements, and matters herein contained and the log of the above-described well as filed and that the same are true and correct. So help me God.

(Signature) Glenn E. Wood
3800 First Place Tower, Tulsa, Okla.
(Address) 74103

SUBSCRIBED AND SWORN TO before me this 8th day of December, 1976

Virginia Barksdale
Notary Public.

My commission expires November 16, 1978