


11-16-57

STATE OF KANSAS
STATE CORPORATION COMMISSION

Give All Information Completely
Make Required Affidavit
Mail or Deliver Report to:
Conservation Division
State Corporation Commission
800 Biting Building
Wichita, Kansas

WELL PLUGGING RECORD 15-033-00022-000

NORTH

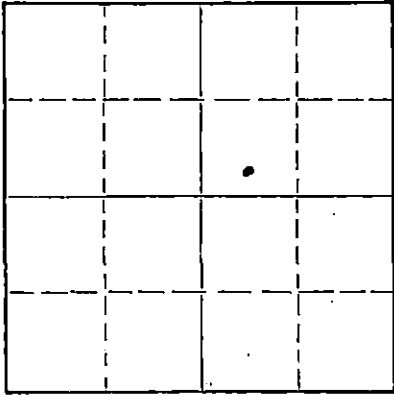

Locate well correctly on above
Section Plat

Comanche County. Sec. 6 Twp. 31S Rge. 16 (W)
Location as "NE/CNW/SW" or footage from lines 561' NSL & 660' EWL of NE/4
Lease Owner Gulf Oil Corporation
Lease Name Gallup-Robbins Well No. 1
Office Address Box 661, Tulsa, Oklahoma
Character of Well (completed as Oil, Gas or Dry Hole) Dry Hole
Date well completed 10-6 19 57
Application for plugging filed 10-11 19 57
Application for plugging approved 10-15 19 57
Plugging commenced 10-26 19 57
Plugging completed 11-1 19 57
Reason for abandonment of well or producing formation Dry Hole

If a producing well is abandoned, date of last production - - 19 -
Was permission obtained from the Conservation Division or its agents before plugging was commenced? Yes

Name of Conservation Agent who supervised plugging of this well M. A. Rives
Producing formation - - - Depth to top - Bottom - Total Depth of Well 5100' Feet
Show depth and thickness of all water, oil and gas formations.

OIL, GAS OR WATER RECORDS

CASING RECORD

FORMATION	CONTENT	FROM	TO	SIZE	PUT IN	PULLED OUT
				8-5/8"	449'	0
				4-1/2"	5002'	4171'

Describe in detail the manner in which the well was plugged, indicating where the mud fluid was placed and the method or methods used in introducing it into the hole. If cement or other plugs were used, state the character of same and depth placed, from _____ feet to _____ feet for each plug set.

Set HOWCO bridging plug at 4820' and spotted 1 1/2 sacks cement on top of plug. Filled hole with mud to 350' and spotted rock bridge and 20 sacks cement on top. Filled with mud to 35' and spotted rock bridge and 10 sacks cement filling hole into cellar.

NOTE: W. C. Bunch - Special Petty Cash, Check No. 1824, dated 11-12-57, in the amount of \$51.00 is attached as payment for plugging assessment.

(If additional description is necessary, use BACK of this sheet)

Name of Plugging Contractor Morgan Well Plugging Service
Address 102 W. 18th Street, Hutchinson, Kansas

STATE OF Kansas, COUNTY OF Sedgwick, ss.
Thomas A. Trax (employee of owner) or (conservator/representative)

well, being first duly sworn on oath, says: That I have knowledge of the facts, statements, and matters herein contained and the log of the above-described well as filed and that the same are true and correct. So help me God.

(Signature) *Thomas A. Trax*

Box 2233, Wichita, Kansas
(Address)

SUBSCRIBED AND SWORN TO before me this 12th day of November, 1957

RECEIVED

My commission expires 6-3-61 STATE CORPORATION COMMISSION

C. C. LEWIS, NOTARY PUBLIC, Notary Public.

JRM:PF

NOV 15 1957

CONSERVATION DIVISION
Wichita, Kansas

PLUGGING
FILE SEC 6 T. 31 R. 16
BOOK PAGE 53 LINE 18

WELL LOG

15-033-00022-0300

COMPANY: Gulf Oil Corporation

Sec. 6-31S-16W

FARM: Gallup-Robbins No. 1

Loc. SW NE

TOTAL DEPTH: 5,100'

County - Comanche

COMD: 8-29-57. COMP: 9-19-57.

CASING

8-5/8" - 438'
4-1/2" -

ELEVATION

D.F. -
Gr. -

DRILLER'S LOG

Surface Clay	0	41
Red Bed	41	258
Red Bed, Shale & Anhydrite	258	1000
Red Bed & Shale	1000	1485
Shale, Salt & Anhydrite	1485	1975
Shale & Shells	1975	2240
Anhydrite & Shale	2240	2346
Lime & Shale	2346	2940
Shale	2940	2976
Lime & Shale	2976	3038
Shale	3038	3805
Lime	3805	3866
Lime & Shale	3866	4264
Lime	4264	4433
Lime & Shale	4433	4564
Lime	4564	4755
Lime & Shale	4755	4879
Chert & Lime	4879	4940
Lime	4940	5038
Lime & Shale	5038	5100
Total Depth		5100

RECEIVED
STATE CORPORATION COMMISSION

OCT 12 1957

CONSERVATION DIVISION
Wichita, Kansas

PLUGGING
 FILE SEC. 6 T 31 R 16W
 BOOK PAGE 53 1518