

Give All Information Completely  
Make Required Affidavit  
Mail or Deliver Report to:  
Conservation Division  
State Corporation Commission  
211 No. Broadway  
Wichita, Kansas

WELL PLUGGING RECORD


10030

1-2-63 15-033-20134-0000

COMANCHE County. Sec. 7 Twp. 31 Rge. 16 (X) (W) X

Location as "NE/CNW&SW4" or footage from lines C NW  
Lease Owner PETROLEUM, INC.  
Lease Name McMILLEN UNIT Well No. 1  
Office Address ROUTE #2, GREAT BEND, KANSAS  
Character of Well (completed as Oil, Gas or Dry Hole) DRY HOLE  
Date well completed NOVEMBER 6, 19 62  
Application for plugging filed NOVEMBER 26, 19 62  
Application for plugging approved NOVEMBER 27, 19 62  
Plugging commenced DECEMBER 14, 19 62  
Plugging completed DECEMBER 20, 19 62  
Reason for abandonment of well or producing formation NO PRODUCIBLE FORMATIONS  
If a producing well is abandoned, date of last production NONE 19  
Was permission obtained from the Conservation Division or its agents before plugging was commenced? YES

NORTH

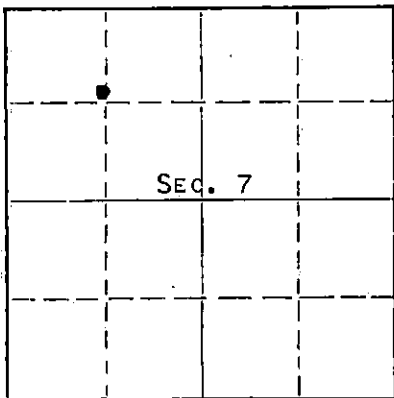

Locate well correctly on above Section Plat

Name of Conservation Agent who supervised plugging of this well HUGH E. SCOTT  
Producing formation \_\_\_\_\_ Depth to top \_\_\_\_\_ Bottom \_\_\_\_\_ Total Depth of Well 4988' (LOGGED) Feet  
Show depth and thickness of all water, oil and gas formations.

OIL, GAS OR WATER RECORDS

CASING RECORD

FORMATION	CONTENT	FROM	TO	SIZE	PUT IN	PULLED OUT
MISSISSIPPI	WATER & SMALL AMOUNT OF GAS	4964	4968	8-5/8"	502'	NONE
				4-1/2"	4986'	4644'

Describe in detail the manner in which the well was plugged, indicating where the mud fluid was placed and the method or methods used in introducing it into the hole. If cement or other plugs were used, state the character of same and depth placed, from \_\_\_\_\_ feet to \_\_\_\_\_ feet for each plug set.

PLUGGED BACK T.D. 4979'

FILLED HOLE WITH CRUSHED ROCK FROM 4979' TO 4910'. PLACED 3 SACKS CEMENT ON TO CRUSHED ROCK. MUDDED UP TO 300' AND BUILT SOLID ROCK BRIDGE. PLACED 20 SACKS CEMENT ON TO ROCK BRIDGE, MUDDED UP TO 40' AND BUILT SOLID ROCK BRIDGE. PLACED 10 SACKS CEMENT ON TO ROCK BRIDGE TO BASE OF WELL CELLAR.

RECEIVED  
STATE CORPORATION COMMISSION

JAN 2 1963

CONSERVATION DIVISION  
Wichita, Kansas

(If additional description is necessary, use BACK of this sheet)

Name of Plugging Contractor SOUTHWEST CASING PULLING CO., INC.  
Address Box 364, GREAT BEND, KANSAS

STATE OF KANSAS, COUNTY OF BARTON, ss.  
DON SEARLE, (employee of owner) or (owner) of the above-described well, being first duly sworn on oath, says: That I have knowledge of the facts, statements, and matters herein contained and the log of the above-described well as filed and that the same are true and correct. So help me God. DON SEARLE, DIST. PROD. SUPT.  
(Signature) Don Searle

ROUTE #2, GREAT BEND, KANSAS  
(Address)

SUBSCRIBED AND SWORN TO before me this 27TH day of DECEMBER, 19 62

My commission expires APRIL 14, 1963 Arthur J. Wiles Notary Public.



# WELL LOG

COMPANY PETROLEUM, INCORPORATED

SEC. 7 T.31S R. 16W

FARM McMILLEN UNIT NO. 1


LOC. Approx. C-NW/4

TOTAL DEPTH 4986'

COUNTY Comanche Co., Kansas

COMM. September 7, 1962 COMP. September 27, 1962

CONTRACTOR GARVEY DRILLING COMPANY

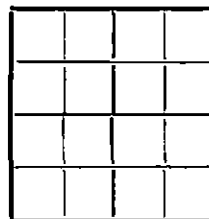

CASING 8-5/8" @ 502' w/300 sax.  
4 1/2" @ 4984' w/75 sax.

ELEVATION 2101' D.F.

PRODUCTION Dry & Abandoned

FIGURES INDICATE BOTTOM OF FORMATIONS

15-633-10030-0000

45	Surface clay
200	Shale
320	Red bed & shale
340	Anhydrite
625	Shale & shells
780	Red bed & shells
900	Shale & sand
1000	Shale & shells
1600	Red bed & shale
2015	Salt & shale
2250	Shale & shells
2325	Lime
2625	Lime & shale
2762	Lime
2970	Lime & shale
3035	Shale & lime
3228	Lime & shale
3630	Shale & lime
3970	Lime & shale
4035	Lime
4458	Shale & lime
4535	Lime & shale
4986=	Lime
4986	T. D.

RECEIVED  
STATE CORPORATION COMMISSION

JAN 2 1963

CONSERVATION DIVISION  
Wichita, Kansas

State of KANSAS  
County of BARTON } ss

I, VERNE A. MORRIS of GARVEY DRILLING COMPANY

upon oath state the above and foregoing is a true and correct copy of the log of the #1 McMILLEN UNIT well.

Subscribed and sworn to before me this 10th day of October 1962

My Commission Expires: April 14, 1963

Verne A. Morris  
Arthur J. Miles  
NOTARY PUBLIC