


Give All Information Completely  
Make Required Affidavit  
Mail or Deliver Report to:  
Conservation Division  
State Corporation Commission  
212 North Market, Insurance Bldg.  
Wichita, Kansas

2-28-61 15-033-00051-0000

WELL PLUGGING RECORD

Comanche County, Sec. 36 Twp. 31S Rge. (E) 16 (W)

Location as "NE/CNW/SW" or footage from lines App. Ctr. S/2 SE/4  
Lease Owner: Messman-Rinehart Oil Company  
Lease Name: Schuette Estate "B" Well No. 1  
Office Address: 518 Petroleum Building, Wichita, Kansas  
Character of Well (completed as Oil, Gas or Dry Hole) Dry Hole  
Date well completed December 21, 1960 19  
Application for plugging filed December 21, 1960 19  
Application for plugging approved December 21, 1960 19  
Plugging commenced December 22, 1960 19  
Plugging completed December 22, 1960 19  
Reason for abandonment of well or producing formation Dry

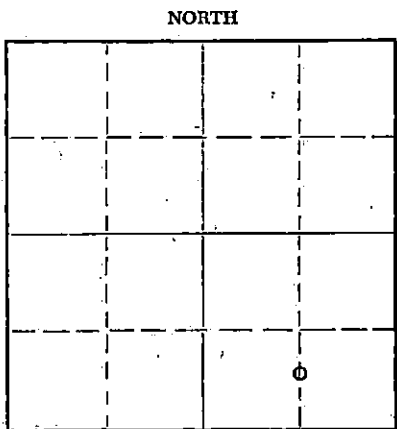

Locate well correctly on above Section Plat

If a producing well is abandoned, date of last production 19  
Was permission obtained from the Conservation Division or its agents before plugging was commenced? yes

Name of Conservation Agent who supervised plugging of this well Mr. Lac Kamp  
Producing formation \_\_\_\_\_ Depth to top \_\_\_\_\_ Bottom \_\_\_\_\_ Total Depth of Well 4990 Feet  
Show depth and thickness of all water, oil and gas formations.

OIL, GAS OR WATER RECORDS

CASING RECORD

FORMATION	CONTENT	FROM	TO	SIZE	PUT IN	PULLED OUT
				10-3/4"	254'	none

Describe in detail the manner in which the well was plugged, indicating where the mud fluid was placed and the method or methods used in introducing it into the hole. If cement or other plugs were used, state the character of same and depth placed, from \_\_\_\_\_ feet to \_\_\_\_\_ feet for each plug set.

Pushed plug and 1/4 sk. hulls to 250 ft.  
and cemented with 25 sx. cement. Filled pipe  
with mud to 35 ft., and set plug with 10 sx.  
cement and 1/4 sk. hulls.

RECEIVED  
STATE CORPORATION COMMISSION

FEB 28 1961

CONSERVATION DIVISION  
Wichita, Kansas

(If additional description is necessary, use BACK of this sheet)  
Name of Plugging Contractor: Messman-Rinehart Oil Company  
Address: 518 Petroleum Building, Wichita, Kansas

STATE OF Kansas, COUNTY OF Sedgwick, ss.  
J. A. Gilliland (employee of owner) or owner or operator of the above-described well, being first duly sworn on oath, says: That I have knowledge of the facts, statements, and matters herein contained and the log of the above-described well as filed and that the same are true and correct. So help me God.

(Signature) J. A. Gilliland  
518 Petroleum Building, Wichita, Kansas  
(Address)

SUBSCRIBED AND SWORN TO before me this 4th day of January, 1961

Barbara J. Scott  
Barbara J. Scott Notary Public.

My commission expires December 1, 1964

NO. 1 SCHUETTE ESTATE "D"

15-033-00051-0000

Well Record:

Location: Ctr. S/2 SE/4, Sec. 35-319-16N  
Comanche County, Kansas

Operator: Hessman-Rinehart Oil Company  
518 Petroleum Building  
Wichita, Kansas

Contractor: Hessman-Rinehart Oil Company  
518 Petroleum Building  
Wichita, Kansas

Commenced: December 5, 1960  
Completed: December 21, 1960  
Elevation: 2001' R/B  
Production: Dry & Abandoned

Casing Record: 10-3/4" @ 254' w/200 sk. con.

\*\*\* LOG \*\*\*

Clay & Red Bed	75
Red Bed & Shale	195
Gyp Rock	228
Red Bed	253
Red Bed & Shale	350
Shale & Red Bed	1308
Shale	1590
Shale, Shells & Salt	1965
Anhydrite	1985
Shale	2080
Lime & Shale	2100
Lime	2305
Shale w/Lime Streaks	2420
Lime	2855
Lime & Shale	3135
Shale & Lime	3335
Lime & Shale	4130
Lime	4175
Lime & Shale	4295
Lime	4600
Lime & Chert	4635
Lime	4707
Lime & Shale	4740
Lime	4790
Lime & Shale	4850
Lime & Chert	4847
Lime & Shale	4980 R.T.D.

Sample Tops:

4120' - Heebner (-2119)  
4284' - Lansing (-2283)  
4049' - Mississippian (-2848)

RECEIVED  
STATE CORPORATION COMMISSION  
FEB 28 1961  
CONSERVATION DIVISION  
Wichita, Kansas

The undersigned, HESSMAN-RINEHART OIL COMPANY, hereby certifies that the above log is a true and correct log of the formation encountered in drilling the above well as reflected by the Daily Drilling Reports.

HESSMAN-RINEHART OIL COMPANY

By: J. A. Gilliland  
J. A. Gilliland

Subscribed and sworn to before me this 4th day January, 1961.

By: Barbara J. Scott  
Barbara J. Scott, Notary Public

My Commission Expires: December 1, 1964