


9-11-54 15-007-10065.0000

WELL PLUGGING RECORD

Give All Information Completely
Make Required Affidavit
Mail or Deliver Report to:
Conservation Division
State Corporation Commission
800 Biting Building
Wichita, Kansas

Barber County, Sec. 7 Twp. 31 Rge. 13 (E) (W)
Location as "NE/CNW%SW%" or footage from lines SW SE SE
Lease Owner National Cooperative Refinery Association
Lease Name Gant "A" Well No. 3
Office Address 305 Rule Building, Wichita, Kansas
Character of Well (completed as Oil, Gas or Dry Hole) Oil
Date well completed July 31, 1947
Application for plugging filed July 21, 1954
Application for plugging approved July 22, 1954
Plugging commenced August 30, 1954
Plugging completed September 2, 1954
Reason for abandonment of well or producing formation Depletion

NORTH

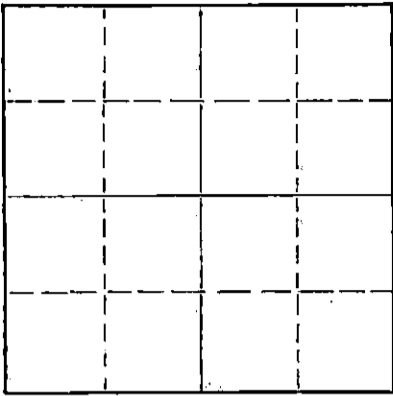

Locate well correctly on above
Section Plat

If a producing well is abandoned, date of last production July, 1952
Was permission obtained from the Conservation Division or its agents before plugging was commenced? Yes

Name of Conservation Agent who supervised plugging of this well Merle Rives
Producing formation _____ Depth to top _____ Bottom _____ Total Depth of Well 4310 Feet
Show depth and thickness of all water, oil and gas formations. PBTD

OIL, GAS OR WATER RECORDS

CASING RECORD

FORMATION	CONTENT	FROM	TO	SIZE	PUT IN	PULLED OUT
				10 3/4"	330'	None
				7"	4686'	3205'

Describe in detail the manner in which the well was plugged, indicating where the mud fluid was placed and the method or methods used in introducing it into the hole. If cement or other plugs were used, state the character of same and depth placed, from _____ feet to _____ feet for each plug set.

Filled hole with sand from 4310' to 4250' and ran 5 sacks of cement. Circulated casing with 25 sacks of jel-mud. Mudded hole to 300', set a 10' rock bridge and ran 25 sacks of cement at 290'. Mudded hole to 20', set a rock bridge and ran 10 sacks of cement on top.

RECEIVED
STATE CORPORATION COMMISSION
SEP 11 1954

(If additional description is necessary, use BACK of this sheet)
Name of Plugging Contractor West Supply Company
Address Chase, Kansas

STATE OF Kansas, COUNTY OF Sedgwick ss.
C. R. Sears (employee of owner) or (operator) of the above-described well, being first duly sworn on oath, says: That I have knowledge of the facts, statements, and matters herein contained and the log of the above-described well as filed and that the same are true and correct. So help me God.

(Signature) C. R. Sears
305 Rule Building, Wichita, Kansas
(Address)

SUBSCRIBED AND SWORN TO before me this 10th day of September, 1954

My commission expires June 30, 1958.

C. Orville May
Notary Public.

PLUGGING
FILE SEC 7 T 31 R 13W
BOOK PAGE 50 LINE 17

July 31, 1947

DRILLING LOG

National Cooperative Refinery Association,
Union National Bank Building,
Wichita 2, Kansas.

15-007-10064-0000

Lease: Gant A #3

County: Barber, Kansas
Sec. 7-31-13
Location: Center of the
SW SE SE

Rotary T.D.: 4718'
Comm: 6-18-47 Comp: 7-21-47
Shot or Treated
Casing: 10 3/4" @ 330: 7" @ 4686:

Contractor: Gabbert & Lindas
1316 Union National Bank Building,
Wichita 2, Kansas

Figures Indicate Bottom of Formations:

0	to	90	Surface Clay & Shells	2855	to	3140	Lime and Shale
90		336	Red Rock and Shells	3140		3155	Shale
336		400	Red Rock	3155		3235	Lime & Shale Breaks
400		500	Shale and Shells	3235		3460	Lime and Shale
500		865	Red Rock and Shells	3460		3530	Lime
865		1300	Shale and Shells	3530		3600	Lime & Shale Breaks
1300		1390	Salt and Shale	3600		3640	Lime
1390		1710	Shale and Shells	3640		3675	Lime and Shale
1710		1855	Lime and Shale	3675		3740	Lime
1855		1905	Lime	3740		3760	Shale and Lime
1905		1970	Chalky Lime & Shale	3760		3764	Lime
1970		2080	Lime and Shale	3764		3787	Douglas Sand
2080		2185	Broken Lime	3787		3835	Lime
2185		2215	Lime	3835		3895	Lime and Shale
2215		2295	Lime & Shale Breaks	3895		4389	Lime
2295		2355	Broken Lime	4389		4416	Shale
2355		2380	Lime	4416		4423	Lime and Shale
2380		2430	Lime & Shale Breaks	4423		4443	Viola Lime
2430		2500	Lime and Shale	4443		4564	Lime
2500		2530	Lime	4564		4622	Shale
2530		2765	Lime and Shale	4622		4718	T. D. Lime
2765		2855	Shale and Shells				

STATE OF KANSAS)
) SS
COUNTY OF SEDGWICK)

STATE CORPORATION DIVISION
JUL 2 1947
CONSERVATION DIVISION

I, the undersigned, being duly sworn on oath state that the above statement and log is true and correct record and log of the well drilled at the location above described.

GABBERT & LINDAS

By Scott Stucky

Subscribed and sworn to before me this 31st day of July, 1947.

PLUGGING
FILE NO. 2131-13W
BOOK PAGE 50 LINE 17

Catherine Parney
Notary Public

My Commission Expires March 25, 1948