

7-18-74


5-007-30229-0000

STATE OF KANSAS
STATE CORPORATION COMMISSION

File All Information Completely
Make Required Affidavit
Mail or Deliver Report to
Conservation Division
State Corporation Commission

P. O. Box 17027
Wichita, Kansas 67217

WELL PLUGGING RECORD

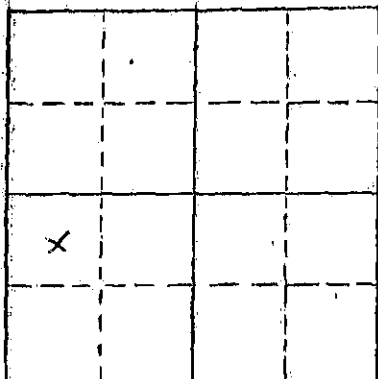

Locate well correctly on above Section Plat

Barber County, Sec. 12 Twp. 31 Rge. 12 (E) W (W)
Location as "NE/CNW/SW" or footage from lines C NE SE
Lease Owner K. & E. Drilling Co.
Lease Name Winter Gress Well No. #1
Office Address 816 Union Center ; Wichita, Ks. 67202
Character of Well (completed as Oil, Gas or Dry Hole) _____
Date well completed _____ 19____
Application for plugging filed June 1974
Application for plugging approved July 1974
Plugging commenced July 3 1974
Plugging completed July 9 1974
Reason for abandonment of well or producing formation Depletion

If a producing well is abandoned, date of last production June 27 1974
Was permission obtained from the Conservation Division or its agents before plugging was commenced? Yes

Name of Conservation Agent who supervised plugging of this well Russell Biberstein
Producing formation Douglas Sand Depth to top 3555' Bottom 3565' Total Depth of Well 3685 Feet
Show depth and thickness of all water, oil and gas formations.

OIL, GAS OR WATER RECORDS

'CASING RECORD

FORMATION	CONTENT	FROM	TO	SIZE	PUT IN	PULLED OUT
				8 5/8"	243	None
				4 1/2"	3687	3079

Describe in detail the manner in which the well was plugged, indicating where the mud fluid was placed and the method or methods used in introducing it into the hole. If cement or other plugs were used, state the character of same and depth placed, from _____ feet to _____ feet for each plug set.

July 3, 1974 Plugged off bottom. Dumped sand to 3500'. Mixed and dumped 4 sx of cement.

July 9, 1974 Plugged off top. Set 10' rock bridge at 240'. Mixed and dumped 35 sx of cement. Mudded casing to 40'. Set 10' rock bridge from 40' to 30'. Mixed and dumped 10 sx of cement from 30' to base of cellar.


RECEIVED
STATE CORPORATION COMMISSION
JUL 18 1974
CONSERVATION DIVISION

Name of Plugging Contractor RUSS CASING PULLING, INC.
Address P. O. Box 1082 ; Great Bend, Ks. 67530

STATE OF Kansas COUNTY OF Sedgwick ss.
Wayne L. Brinegar (employee of owner) or (owner or operator) of the above-described

well, being first duly sworn on oath, says: That I have knowledge of the facts, statements, and matters herein contained and the log of the above-described well as filed and that the same are true and correct. So help me God.

(Signature) Wayne L. Brinegar
816 Union Center Building, Wichita, Kansas 67202
(Address)

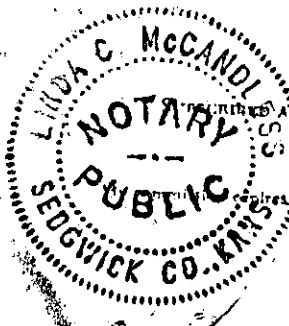

Subscribed and sworn to before me this 16th day of July, 1974
March 29, 1977

Linda C. McCandless
Notary Public.

DRILLER'S WELL LOG

OPERATOR: K. & E Drilling, Inc.
719 Union Center
Wichita, Kansas

WELL NAME: #1-12 Winter Gress
LOCATION: C NE SE 13
Sec. 12-31S-12W
Barber County, Kansas

CONTRACTOR: K&E DRILLING, INC.
719 UNION CENTER BLDG.
WICHITA, KANSAS.

COMMENCED: 1-28-66

CASING RECORD: 8-5/8" @ 243' w/175 sx.
4-1/2" @ 3680 w/100 sx.

COMPLETED: 2-6-66

ROTARY TOTAL DEPTH: 3685

ELEVATION: 1610' Grd. 1616 DF
1619 KB
PRODUCTION: Gas

FORMATION RECORD

Depths shown indicate bottom of formations encountered.

Sand	35
Red Bed & Shale	105
Red Bed	490
Shale & Shells	1420
Shale	1596
Lime	3685 T.D.

RECEIVED
STATE CORPORATION COMMISSION

JUL 11 1974

CONSERVATION DIVISION
Wichita, Kansas

CERTIFICATION

State of KANSAS }
County of SEDGWICK } ss:

I, H. L. Wilson, of K&E DRILLING, INC., upon oath state that the above and foregoing is a true and correct copy of the Driller's Log of the above named well.

Subscribed and sworn to before me this 10th day of February, 19 66

My Commission expires: 8-30-69

H. L. Wilson
H. L. Wilson
Julene M. Bannon
Julene M. Bannon Notary Public.

