


STATE OF KANSAS  
STATE CORPORATION COMMISSION

Give All Information Completely  
Make Required Affidavit  
Mail or Deliver Report to:  
Conservation Division  
State Corporation Commission,  
800 Bittling Building,  
Wichita, Kansas

NORTH

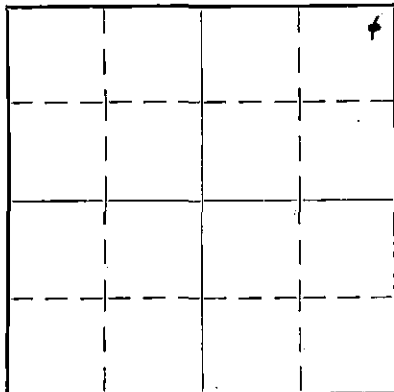

Locate well correctly on above  
Section Plat

Name of Conservation Agent who supervised plugging of this well

Tom Johns

Producing formation

Depth to top

Bottom

Total Depth of Well

3899 Feet

Show depth and thickness of all water, oil and gas formations.


OIL, GAS OR WATER RECORDS

CASING RECORD

Formation	Content	From	To	Size	Put In	Pulled Out
				12 1/2"	127'	

Describe in detail the manner in which the well was plugged, indicating where the mud fluid was placed and the method or methods used in introducing it into the hole. If cement or other plugs were used, state the character of same and depth placed, from \_\_\_\_\_ feet to \_\_\_\_\_ feet for each plug set.

Hole was filled with 12# rotary mud to 115'. It was bridged with a wood plug and filled with 25 sacks cement. Top plate was welded over the top of surface pipe (12 1/2")

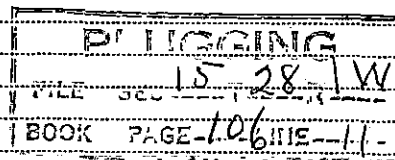

(If additional description is necessary use BACK of this sheet)

Correspondence regarding this well should be addressed to

The Palmer Oil Corporation

Address

415 Union National Bank Building, Wichita, Kansas

STATE OF

Kansas

COUNTY OF

Sedgwick

ss.

R. E. Holmes

(employee of owner) or (owner or operator)

being first duly sworn on oath, says: That I have knowledge of the facts, statements, and matters herein contained and the log of the above-described well as filed and that the same are true and correct. So help me God.

(Signature)

R. E. Holmes

Wichita, Kansas

(Address)

SUBSCRIBED AND SWORN to before me this 30th day of

August

1937.

My commission expires

March 3, 1941

16-1484

11-36-5M

Notary Public.

**TOM PALMER**  
UNION NATIONAL BANK BUILDING  
WICHITA, KANSAS

15-173-01704-0000

CASING RECORD		Location	NE NE NE Sec. 15-28-13
RUN	LEFT IN HOLE	Farm	Royal #1
20		County	Sedgewick State Kansas
15 1/2		Contractor	The Palmer Oil Corporation
12 1/2	127'	Commence	8/8/37
10		Completed	8/29/37
8 1/4		Elevation	1310'
6 5/8			
5 3/16			

FORMATION	REMARKS	FEET OF STRATA	TOTAL DEPTH
Clay & Sand	(Set surface pipe)	127	127
Shale & Shells		338	565
Broken Lime		85	650
Shale		35	685
Lime		25	710
Shale		120	830
Broken Lime		140	970
Shale & Shells		85	1055
Shale		75	1130
Lime		15	1145
Sandy Shale		95	1240
Shale		550	1790
Shale & Shells		215	2005
Shale		55	2060
Lime		60	2120
Lime, Broken		160	2280
Shale & Lime		125	2405
Lime		70	2475
Shale		55	2530
Broken Lime		40	2570
Lime		15	2585
Sand		35	2620
Shale & Shells		170	2790
Shale & Lime		100	2890
Lime		125	3015
Broken Lime		170	3185
Shale & Lime		80	3265
Shale & Shells		50	3315
Shale		82	3397
Chert		33	3430
Lime		148	3578
Hard Lime		12	3590
Lime		10	3600
Hard Lime		30	3630
Lime		115	3745 - 2
Shale		30	3775
Sand		28	3803
Lime & Pyrite		22	3825
Sand & Lime		31	3856
Lime		10	3866
Sand & Lime		33	3899
			TD

Dry hole - plugged and abandoned

106-11