

Give All Information Completely
Make Required Affidavit
Mail or Deliver Report to:
Conservation Division
State Corporation Commission
211 No. Broadway
Wichita, Kansas

WELL PLUGGING RECORD 15-173 - 30096-0000

Sedgwick County, Sec. 19 Twp. 28 Rge. 1 ~~XX~~ (W)

Location as "NE/CNW%SW%" or footage from lines C S/2 S/2 NE/4

Lease Owner SeRoBee-Shaffer & Terry

Lease Name Neises Well No. 1

Office Address 5301 N. Broadway

Character of Well (completed as Oil, Gas or Dry Hole) Oil Well

Date well completed 11-25 19 65

Application for plugging filed 7-6 19 66

Application for plugging approved 7-6 19 66


Plugging commenced 7-6 19 66

Plugging completed 7-15 19 66

Reason for abandonment of well or producing formation depleted

If a producing well is abandoned, date of last production _____ 19 _____

Was permission obtained from the Conservation Division or its agents before plugging was commenced? yes

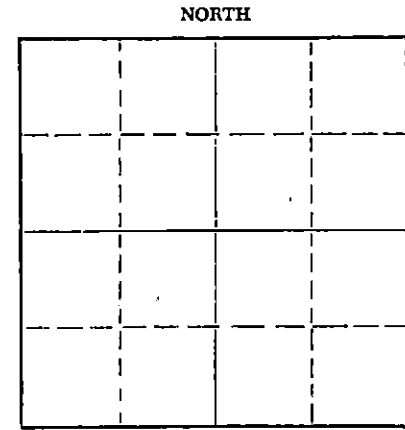

Locate well correctly on above Section Plat

Name of Conservation Agent who supervised plugging of this well Paul Turpin

Producing formation _____ Depth to top _____ Bottom _____ Total Depth of Well 3428 Feet

Show depth and thickness of all water, oil and gas formations.

OIL, GAS OR WATER RECORDS

CASING RECORD

FORMATION	CONTENT	FROM	TO	SIZE	PUT IN	PULLED OUT
				8 5/8	170'	none
				5 1/2"	3402'	2875'

Describe in detail the manner in which the well was plugged, indicating where the mud fluid was placed and the method or methods used in introducing it into the hole. If cement or other plugs were used, state the character of same and depth placed, from _____ feet to _____ feet for each plug set.

Filled hole with sand from 3428 to 3400 & dumped 5 sx cement

Set 15' rock bridge from 200' to 185' & dumped 3 cubic yards of ready mix concrete to surface

RECEIVED
STATE CORPORATION COMMISSION

JUL 26 1966

CONSERVATION DIVISION
WICHITA, KANSAS

(If additional description is necessary, use BACK of this sheet)

Name of Plugging Contractor Flint Engineering & Construction Co.

Address 2375 W. Central, El Dorado, Kansas

STATE OF Kansas, COUNTY OF Sedgwick, ss.

Paul S. Septer (employee of owner) or (owner or operator) of the above-described well, being first duly sworn on oath, says: That I have knowledge of the facts, statements, and matters herein contained and the log of the above-described well as filed and that the same are true and correct. So help me God.

(Signature) Paul S. Septer

5301 N. Broadway, Wichita

(Address)

SUBSCRIBED AND SWORN TO before me this 19th day of July, 19 66

Frances H. Solomon
Frances H. Solomon

Notary Public.

My commission expires Oct. 10, 1967

15-173-30096-0000 69

KANSAS GEOLOGICAL SOCIETY
KANSAS WELL LOG BUREAU - KANSAS WELL SAMPLE BUREAU
 KANSAS GEOLOGICAL SOCIETY BUILDING
 508 EAST MURDOCK - WICHITA, KANSAS

COMPANY **SeRoBee, Shaffer & Terry**

SEC. 19 T. 28 R. 1W
 LOG. C S/2 S/2 NE/4


FARM **Neises** NO. 1

TOTAL DEPTH **3428'**
 COMM. **11-16-65**

COMP. **11-26-65**

COUNTY **Sedgwick**
 KANSAS

SHOT OR TREATED
 CONTRACTOR **SeRoBee Drilling Co., Inc.**
 ISSUED

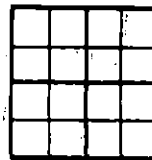

CASING

20	10	
15	8	5/8 @ 170 W/175 Sx Cement
12	6	
13	5	1/2 @ 3402 W/65 Sx Cement

ELEVATION: **1321 DF**

PRODUCTION

FIGURES INDICATE BOTTOM OF FORMATIONS

8 -	
0 - 20	Surface Clay
20 - 140	Sand
140 - 760	Shale & Lime
760 - 940	Lime
940 - 2775	Shale & Lime
2775 - 2990	K. C. Lime
2990 - 3399	Shale & Lime
3399 - 3428	Mississippi Chat (T. D.)

RECEIVED
 STATE CORPORATION COMMISSION
AUG 3 1966
 CONSERVATION DIVISION
 Wichita, Kansas

I certify the above to be a true and correct copy of the geological tops to the best of my knowledge and belief.

SEROBEE DRILLING CO., INC.

Paul S. Septer
 Paul S. Septer, President

