

CARD MUST BE TYPED

State of Kansas
NOTICE OF INTENTION TO DRILL
(see rules on reverse side)

CARD MUST BE SIGNED

Starting Date: January 14, 1985
month day year

API Number 15- 151-21,218-~~8~~⁰⁰⁻⁰¹

OPERATOR: License # 5027

C. SE SE... Sec 7... Twp 28... S, Rge 12... East
(location) West

Name J. A. Allison

Address 300 West Douglas, Suite 305

City/State/Zip Wichita, Kansas 67202

Contact Person J. A. Allison

Phone 316-263-2241

660... Ft North from Southeast Corner of Section

660... Ft West from Southeast Corner of Section

(Note: Locate well on Section Plat on reverse side)

CONTRACTOR: License # 5381

Nearest lease or unit boundary line 660 feet.

County PRATT

Lease Name DeWeese Well# 1

Name Big Springs Drilling, Inc.

City/State P.O. Box 8287 - Munger Station, Wichita, KS: 67208

Domestic well within 330 feet: yes no

Municipal well within one mile: yes no

Well Drilled For: Well Class: Type Equipment:

Oil Swd Infield Mud Rotary

Gas Inj Pool Ext. Air Rotary

OWWO Expl Wildcat Cable

Depth to Bottom of fresh water 175 feet

Lowest usable water formation Top of Permian

Depth to Bottom of usable water 200 feet

Surface pipe by Alternate: 1 2 (Already set)

Surface pipe to be set 8-5/8" Already set @ 1009' feet

Conductor pipe if any required 13-3/8" @ 266' feet

Ground surface elevation 1864 feet MSL

This Authorization Expires 7-10-85

Approved By [Signature]

If OWWO: old well info as follows:

Operator Arrowhead Petroleum, Inc.

Well Name DeWeese #1

Comp Date 12/23/82 Old Total Depth 4526'

Projected Total Depth 4250 feet

Projected Formation at TD Mississippian

Expected Producing Formations Mississippian

I certify that we will comply with K.S.A. 55-101, et seq., plus eventually plugging hole to K.C.C. specifications.

Date Jan. 9, 1985 Signature of Operator or Agent

J. A. Allison

Title Operator


Form C-1 4/84

MHC/NOHE 1-10-85

Must be filed with the K.C.C. five (5) days prior to commencing well
This card void if drilling not started within six (6) months of date received by K.C.C.

Important procedures to follow :

**A Regular Section of Land
1 Mile = 5,280 Ft.**

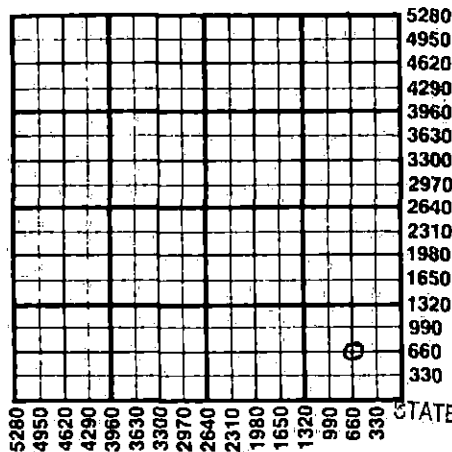

1. Notify District office before setting surface casing.
2. Set surface casing by circulating cement to the top.
3. File completion forms ACO-1 with K.C.C. within 90 days of well completion, following instructions on ACO-1, side 1, and including copies of wireline logs.
4. Notify District office 48 hours prior to old well workover or re-entry.
5. Prior to plugging, prepare a plugging plan, then obtain agreement from the appropriate district office for an approved plugging plan.
6. Submit plugging report (CP-4) to K.C.C. after plugging is completed.
7. Obtain an approved injection docket number before disposing of salt water.
8. Notify K.C.C. within 10 days when injection commences or terminates.
9. If an alternate 2 completion, cement in the production pipe from below to usable water to surface within 120 days of spud date:

RECEIVED

STATE CORPORATION COMMISSION

State Corporation Commission of Kansas

Conservation Division

200 Colorado Derby Building

Wichita, Kansas 67202

(316) 263-3238

JAN 10 1985

CONSERVATION DIVISION
Wichita, Kansas