

CARD MUST BE TYPED

State of Kansas

CARD MUST BE SIGNED

NOTICE OF INTENTION TO DRILL

(see rules on reverse side)

Starting Date 11-7-86 month day year

API Number 15-151-21,813-00-80

OPERATOR: License # 5829
Name ALDEBARAN DRILLING CO., INC.
Address 9440 BOSTON, BOX 782290
City/State/Zip WICHITA, KANSAS 67278-2290
Contact Person MICHAEL W. KIRKMAN
Phone (316) 685-5372

SE NE NE Sec. 15. Twp. 28. S, Rg. 12. West
4290 Ft. from South Line of Section
330 Ft. from East Line of Section

(Note: Locate well on Section Plat on reverse side)

CONTRACTOR: License # 5829
Name ALDEBARAN DRILLING CO., INC.
City/State WICHITA, KANSAS 67278-2290

Nearest lease or unit boundary line 330 feet
County PRATT

Lease Name ROSENBAUM Well # E-2

Ground surface elevation 1867 feet MSL

Domestic well within 330 feet: yes X no

Municipal well within one mile: yes X no

Depth to bottom of fresh water 215

Depth to bottom of usable water 250

Surface pipe by Alternate: 1 X 2

Surface pipe planned to be set 250

Conductor pipe required

Projected Total Depth 4900 feet

Formation ARBUCKLE

Well Drilled For: Well Class: Type Equipment:
X Oil SWD Infield X Mud Rotary
X Gas Inj Pool Ext Air Rotary
OWWO Expl X Wildcat Cable

If OWWO: old well info as follows:

Operator
Well Name
Comp Date Old Total Depth

I certify that well will comply with K.S.A. 55-101, et seq., plus eventually plugging hole to KCC specifications. MICHAEL W. KIRKMAN

Date 11-5-86 Signature of Operator or Agent Michael W. Kirkman Title VICE-PRESIDENT X

For KCC Use:

Conductor Pipe Required feet; Minimum Surface Pipe Required 250 feet per Alt. 109


This Authorization Expires 5-5-87 Approved By 11-5-86

Must be filed with the K.C.C. five (5) days prior to commencing well
This card void if drilling not started within six (6) months of date received by K.C.C.

Important procedures to follow:

1. Notify District office before setting surface casing.
2. Set surface casing by circulating cement to the top.
3. File completion forms ACO-1 with K.C.C. within 90 days of well completion, following instructions on ACO-1, side 1, and including copies of wireline logs.
4. Notify District office 48 hours prior to old well workover or re-entry.
5. Prior to filing Intent, prepare a proposed plugging plan in case well is D & A, then obtain approval of plan when calling district office prior to setting surface pipe.
6. Submit plugging report (CP-4) to K.C.C. after plugging is completed.
7. Obtain an approved injection docket number before disposing of salt water.
8. Notify K.C.C. within 10 days when injection commences or terminates.

**A Regular Section of Land
1 Mile = 5,280 Ft.**

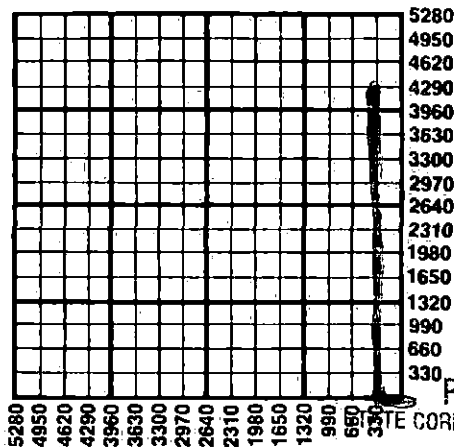

RECEIVED

NOV 5 1986

CONSERVATION DIVISION
Wichita, Kansas

State Corporation Commission
In an alternate 2 completion, cement in the production pipe from below any usable water to surface within 120 days of spud date.

State Corporation Commission of Kansas
Conservation Division
200 Colorado Derby Building
Wichita, Kansas 67202
(316) 263-3238