

STATE OF KANSAS
STATE CORPORATION COMMISSION


Form CP-4

15-173-61678-0000
WELL PLUGGING RECORD

Give All Information Completely
Make Required Affidavit
Mail or Deliver Report to:
Conservation Division
State Corporation Commission
212 No. Market
Wichita, Kansas

Sedgwick County, Sec. 36 Twp. 28S Rge. 1 (W)

Location as "NE/CNW/SW" or footage from lines NW NE NE
Lease Owner Kewanee Oil Company
Lease Name Tract 10 Well No. 3
Office Address Box 157, Haysville, Kansas
Character of Well (completed as Oil, Gas or Dry Hole) Oil
Date well completed 4-17 1955
Application for plugging filed 4-12 1966
Application for plugging approved 4-13 1966
Plugging commenced 5-21 1966
Plugging completed 5-27 1966
Reason for abandonment of well or producing formation Uneconomical

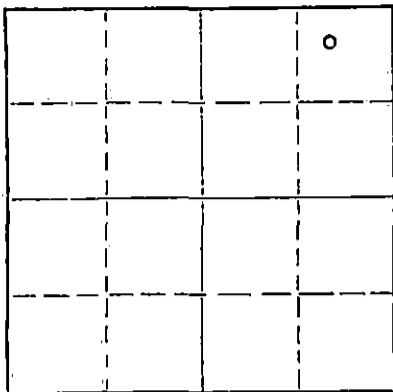

Locate well correctly on above Section Plat

If a producing well is abandoned, date of last production March 1964
Was permission obtained from the Conservation Division or its agents before plugging was commenced? Yes

Name of Conservation Agent who supervised plugging of this well Paul Turpin
Producing formation Kansas City Depth to top 2662 Bottom _____ Total Depth of Well 3195 Feet
Show depth and thickness of all water, oil and gas formations.

OIL, GAS OR WATER RECORDS

CASING RECORD

FORMATION	CONTENT	FROM	TO	SIZE	PUT IN	PULLED OUT
Stalnaker		2354		8-5/8"	163'	
Kansas City		2662		5-1/2"	3183'	2340'
Base Kansas City		2852				
Miss. Lime		3169				
Miss. Dolomite		3182				

Describe in detail the manner in which the well was plugged, indicating where the mud fluid was placed and the method or methods used in introducing it into the hole. If cement or other plugs were used, state the character of same and depth placed, from _____ feet to _____ feet for each plug set.

Set bridge plug at 2740'. Pulled 74 joints 2340' of 5 1/2" casing. Set 15' rock bridge at 190' and bailed hole down. Filled to surface with ready-mix concrete.

RECEIVED
STATE CORPORATION COMMISSION

JUN - 6 1966
6-6-1966
CONSERVATION DIVISION
Wichita, Kansas

(If additional description is necessary, use BACK of this sheet)
Name of Plugging Contractor Flint Rig
Address El Dorado, Kansas

STATE OF KANSAS, COUNTY OF SEDGWICK, ss.
Kenneth K. Knapp (employee of owner) or (owner or operator) of the above-described well, being first duly sworn on oath, says: That I have knowledge of the facts, statements, and matters herein contained and the log of the above-described well as filed and that the same are true and correct. So help me God.

(Signature) Kenneth K. Knapp
Box 157, Haysville, Kansas
(Address)

SUBSCRIBED AND SWORN to before me this 3rd day of June, 1966

My commission expires August 2, 1969

Ann B. McNeil
Notary Public.

Q

36-28-1W

E. H. ADAIR OIL COMPANY
WICHITA 7, KANSAS.

15-173-01678-0000

TRACT 10

E. H. Adair Oil Company
#3 Wright
T4 NE NE Sec. 36-28S.-1W
Sedgwick County, Kansas.

Comm. 4/6/55
Comp. 4/17/55
3-5/8 csg. 3163'
w/130 sx. cement
5-1/2 csg. 3183'
w/100 sx. cement

Elev. 1235 KB

Figures indicate bottoms of
formations

Shale & lime	to 243	Shale	to 2,340
Lime & shale	730	Sand	2,440
Shale	1,015	Lime & shale	2,570
Shale & lime	1,412	Shale	2,665
Shale	1,621	Lime	2,840
Lime & shale	2,000	Shale	3,173
Shale & shells	2,158	Lime	3,183
		Dolomite	3,195

RECEIVED
STATE CORPORATION COMMISSION

APR 13 1966

CONSERVATION DIVISION
Wichita, Kansas