


STATE OF KANSAS
STATE CORPORATION COMMISSION

15-173-61679-6000
WELL PLUGGING RECORD

Form CP-4

Give All Information Completely
Make Required Affidavit
Mail or Deliver Report to:
Conservation Division
State Corporation Commission
P. O. Box 17027
Wichita, Kansas 67217
NORTH

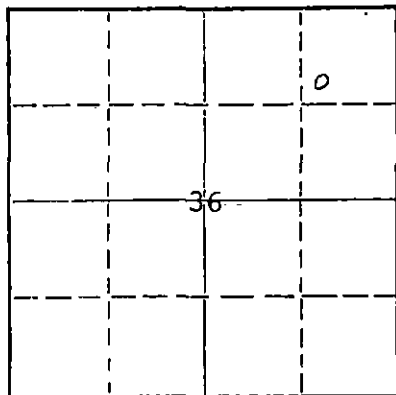

Locate well correctly on above Section Plat

Sedgwick County. Sec. 36 Twp. 28 Rge. 1W (E) (W)
Location as "NE/CNW/SW" or footage from lines SW NE NE
Lease Owner Kewanee Oil Company
Lease Name Gladys Unit -0-, Tract 10 Well No. 4
Office Address P. O. Box 2093, Wichita, Kansas 67201
Character of Well (completed as Oil, Gas or Dry Hole) High-WOR Oil
Date well completed 7-2-1955
Application for plugging filed 8-16-1972
Application for plugging approved 8-17-1972
Plugging commenced 8-29-1972
Plugging completed 10-10-1972
Reason for abandonment of well or producing formation High WOR

If a producing well is abandoned, date of last production June 1964
Was permission obtained from the Conservation Division or its agents before plugging was commenced? Yes

Name of Conservation Agent who supervised plugging of this well Ted Dewey
Producing formation Miss. Dolomite Depth to top 3197 Bottom _____ Total Depth of Well 3212 Feet
Show depth and thickness of all water, oil and gas formations.

OIL, GAS OR WATER RECORDS

CASING RECORD

FORMATION	CONTENT	FROM	TO	SIZE	PUT IN	PULLED OUT
Kansas City		2670		8-5/8"	169	none
				5-1/2"	3197	2208

Describe in detail the manner in which the well was plugged, indicating where the mud fluid was placed and the method or methods used in introducing it into the hole. If cement or other plugs were used, state the character of same and depth placed, from _____ feet to _____ feet for each plug set.

Ran Halliburton EZ drill packer on 2" tubing and set @ 3092'. Pumped 100 sacks cement into formation @ 1950#. Pulled out of packer and dumped 1/2 bbl. cement on top of packer.

Shot pipe and recovered 2208' of 5-1/2". Set rock bridge from 220-200'. Dumped 4 cu.yd. ready mix cement to surface.

RECEIVED
STATE CORPORATION COMMISSION

OCT 13 1972

CONSERVATION DIVISION
Wichita, Kansas

10-13-1972

(If additional description is necessary, use BACK of this sheet)
Name of Plugging Contractor Flowers Well Service
Address Peabody, Kansas

Kansas, COUNTY OF Sedgwick, ss.

C. W. Mosier (employee of owner) or (owner) of the above-described well, being first duly sworn on oath, says: That I have knowledge of the facts, statements, and matters herein contained and the log of the above-described well as filed and that the same are true and correct. So help me God.

(Signature) C. W. Mosier

Box 2093, Wichita, Kansas 67201

(Address)

SUBSCRIBED AND SWORN TO before me this 12th day of October, 19 72

My commission expires 8-10-75

Billie Oden
Billie Oden

Notary Public.

RECEIVED
STATE CORPORATION COMMISSION
AUG 17 1972
CONSERVATION DIVISION
Wichita, Kansas

Kewanee Oil Company
Gladys Unit -0-
Tract 10, Well No. 4

E. H. Adair Oil Company
Wichita 7, Kansas.

15-173-61679-0000

E. H. Adair Oil Company
L. Wright #4
SW NE NE
Sec. 36-28S. 1W.
Sedgwick County, Kansas.
Elev. 1287 KB.

Comm. 6-24-55
Comp. 7-2-55 w/rotary
Cont. Rig# 1 - Adair.
8-5/8" @ 169' w/135 sx.
5-1/2" @ 3197' w/100 sx.
Pro. 716 BOPD-Flowing
State Pot.

Figures indicate bottoms of formations

Shale	to 6	Lime, porous	to 2811
Sand	55	Lime	2859
Shale & shells	189	Shale	2902
Shale & lime	631	Lime	2914
Shale & shells	812	Sand & shale	2931
Lime & shale	1403	Lime	2954
Shale & shells	2051	Black shale	2957
Black shale	2054	Shaley lime	3012
Lime	2122	Black shale	3014
Shale	2312	Shale & lime	3049
Lime	2315	Black shale	3052
Shale	2344	Shaley lime	3073
Sand	2434	Black shale	3077
Lime	2490	Shaley lime	3109
Shale	2670	Black shale	3111
Lime	2758	Shale & lime	3147
Lime, porous	2762	Varicolored shale	3176
Lime	2776	Chert & shale	3189
Black shale	2780	Lime	3197
Porous lime,		Dolomite, good	
show oil	2784	show oil	3212
Lime	2802		
Black shale	2804		

Formation Tops

Lansing	2312
Stalnaker	2344
K. C.	2670
Base K. C.	2859
Conglomerate	3176
Miss. Lime	3189
Miss. "Dolomite"	3197

Certified Correct:

K. W. Johnson - Geologist.