

R


STATE OF KANSAS
STATE CORPORATION COMMISSION

Give All Information Completely
Make Required Affidavit
Mail or Deliver Report to:
Conservation Division
State Corporation Commission
212 No. Market
Wichita, Kansas 67202

15-173-01688-0000
WELL PLUGGING RECORD

Form CP-4

NORTH

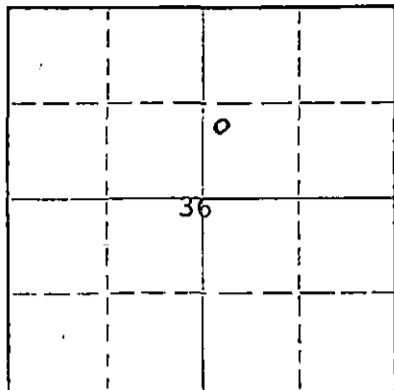

Locate well correctly on above
Section Plat

Sedgwick County, Sec. 36 Twp. 28S Rge. 1W (E) (W)
Location as "NE/CNW/SW" or footage from lines NW SW NE

Lease Owner Kewanee Oil Company

Lease Name Gladys Unit, Tract 10 Well No. 13 WI

Office Address P. O. Box 157, Haysville, Kansas 67060

Character of Well (completed as Oil, Gas or Dry Hole) oil

Date well completed 11-21- 19 55

Application for plugging filed 8-11- 19 71

Application for plugging approved 8-16- 19 71

Plugging commenced 8-24- 19 71

Plugging completed 10-9- 19 71

Reason for abandonment of well or producing formation no longer needed as
input well.

If a producing well is abandoned, date of last production 19

Was permission obtained from the Conservation Division or its agents before plugging was commenced? yes

Name of Conservation Agent who supervised plugging of this well Ted Dewey

Producing formation Mississippi Depth to top 3208 Bottom Total Depth of Well 3216 Feet

Show depth and thickness of all water, oil and gas formations.

OIL, GAS OR WATER RECORDS

CASING RECORD

FORMATION	CONTENT	FROM	TO	SIZE	PUT IN	PULLED OUT
Kansas City		2678		8-5/8 5-1/2	170' 3204'	2269'

Describe in detail the manner in which the well was plugged, indicating where the mud fluid was placed and the method or methods used in introducing it into the hole. If cement or other plugs were used, state the character of same and depth placed, from feet to feet for each plug set.

Ran Halliburton EZ drill packer on 2"
tubing set @ 3097'. Pumped 100 sacks
Pozmix @ 1800 psi. Pulled out of packer
and dumped 1/2 barrel cement on top.

Ripped casing and recovered 2269' of 5-1/2"
casing. Set rock bridge from 220-235'
Dumped 4 cu.yds. ready mix to surface

RECEIVED
OCT 22 1971
STATE CORPORATION COMMISSION
CONSERVATION DIVISION
Wichita, Kansas

(If additional description is necessary, use BACK of this sheet)

Name of Plugging Contractor Flint Engineering Company

Address Eldorado, Kansas

STATE OF Kansas, COUNTY OF Sedgwick, ss. S. A. Park (employee of owner) or (~~owner operator~~) of the above-described

well, being first duly sworn on oath, says: That I have knowledge of the facts, statements, and matters herein contained and the log of the above described well as filed and that the same are true and correct. So help me God.

(Signature) [Signature]

P. O. Box 157, Haysville, Kansas


(Address)

Subscribed and sworn to before me this 18th day of October, 19 71

[Signature]
Billie Oden

Notary Public.

My commission expires 8-10-75

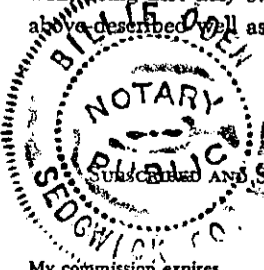

9

Gladys Unit
Tr. 10 #13

E. H. Adair Oil Company
Wichita 7, Kansas

19-173-01688-0000

E. H. Adair Oil Company, et al,
L. Wright No. 13
NW SW NE of
Sec. 36-28S.-1W.,
Sedgwick County, Kansas.

Contractor: Adair
Rig No. 3.
Comm.: 11-14-55
Comp.: 11-21-55
8-5/8 @ 170 ft. w/115 sx.
5-1/2 @ 3204 ft. w/100 sx.

Elev.: 1291 K.B.

Figures indicate bottoms of Formations

Lime & shells	to	230	Shale	to	2939
Lime & shale		625	Lime		2964
Sand & lime		730	Shale		2980
Lime		780	Shaley lime		3025
Shale & lime		1055	Black shale		3027
Shale & shells		1400	Shale		3063
Lime & shale		1800	Black shale		3065
Lime		2055	Shale		3074
Lime & shale		1800	Lime		3079
Lime		2055	Shale		3085
Lime & shale		2335	Black shale		3089
Sand		2464	Shale		3108
Shale & lime		2495	Lime		3120
Shale		2678	Black shale		3123
Lime		2684	Lime & colored shale		3186
Shale		2687	Chert		3188
Lime		2733	Lime		3208
Shale		2735	Dolomite		3213
Lime		2786	R.T.D.		3213
Black shale		2790			
Lime		2876			
Shale		2907			
Lime		2925			

RECEIVED
STATE CORPORATION COMMISSION
AUG 16 1971
CONSERVATION DIVISION
Wichita, Kansas

Tops

Kansas City	2678	(-1387)
Base K. C.	2876	(-1585)
Miss. Chert	3186	(-1895)
Miss. Lime	3188	(-1897)
Miss. Dolomite	3208	(-1917)
R.T.D.	3213	

Certified correct:

Sherrill Compton - Geologist.