

STATE OF KANSAS  
STATE CORPORATION COMMISSION

WELL PLUGGING RECORD


Give All Information Completely  
Make Required Affidavit  
Mail or Deliver Report to:  
Conservation Division  
State Corporation Commission  
800 Bittling Building  
Wichita, Kansas

OR  
FORMATION PLUGGING RECORD

Strike out upper line  
when reporting plug-  
ging off formations.

Pratt County. Sec. 29 Twp. 28S Rge. (E) 12 (W)  
Location as "NE 1/4 NW 1/4 SW 1/4" or footage from lines SW Corner SW/4 SE/4  
Lease Owner. Lion Oil Company  
Lease Name. Fincham Well No. 1  
Office Address. Box 552, Pratt, Kansas  
Character of Well (completed as Oil, Gas or Dry Hole) Dry Hole  
Date well completed. 7-26-45  
Application for plugging filed. 8-21-45  
Application for plugging approved. 8-21-45  
Plugging commenced. 8-21-45  
Plugging completed. 8-23-45  
Reason for abandonment of well or producing formation. Dry Hole

NORTH

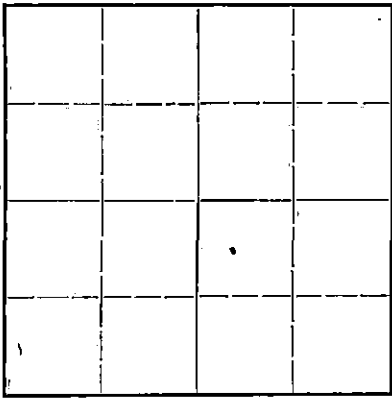

Locate well correctly on above  
Section Flat

Name of Conservation Agent who supervised plugging of this well. H. W. Kerr  
Producing formation. None Depth to top. None Bottom. None Total Depth of Well. 4698 Feet  
Show depth and thickness of all water, oil and gas formations.


OIL, GAS OR WATER RECORDS

CASING RECORD

Formation	Content	From	To	Size	Put In	Pulled Out
				5 1/2" OD	4496'	2552'
				8 5/8" OD	330	None

Describe in detail the manner in which the well was plugged, indicating where the mud fluid was placed and the method or methods used in introducing it into the hold. If cement or other plugs were used, state the character of same and depth placed, from \_\_\_\_\_ feet to \_\_\_\_\_ feet for each plug set.  
Plug set @ 3935', run 10 sacks cement. Mud to 200' and set plug with 15 sacks cement.  
Mud to 25', set plug and run 10 sacks cement.

FILED  
29 28 12 26  
24 23

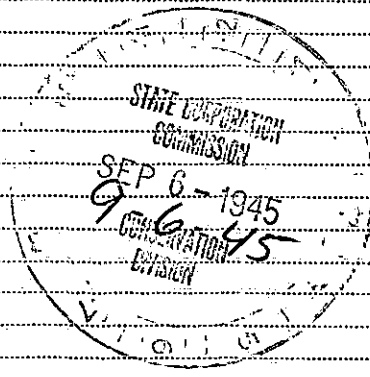

(If additional description is necessary, use BACK of this sheet)

Correspondence regarding this well should be addressed to. Vernon Hayes  
Address. P. O. Box 552  
Pratt, Kansas

STATE OF KANSAS, COUNTY OF PRATT, ss.  
VERNON HAYES (employee of owner) or (owner or operator) of the above-described well,  
being first duly sworn on oath, says: That I have knowledge of the facts, statements, and matters herein contained and the log of the above-described well as filed and that the same are true and correct. So help me God.

(Signature) *V. Hayes*  
P. O. Box 552, Pratt, Kansas  
(Address)

SUBSCRIBED AND SWORN to before me this 4 th day of September, 1945.  
*Rush Warren*  
Notary Public.

My commission expires. *Oct 18 - 45*