



FEDERAL EXPRESS

February 10, 1993

Kansas Corporation Commission
200 Colorado Derby Building
202 W. 1st. Street
Wichita KS 67202

Attn: Mr. Bill Wix

Re: Change of Attributable Acreage
Moorhead #1-13
Sec. 13-T31S-R35W
Stevens County, Kansas

RECEIVED
KANSAS CORPORATION COMMISSION
FEB 11 1993
CONSERVATION DIVISION
WICHITA, KS

Per our phone conversation of January 28, 1993, Mesa desires to change the dedicated acreage attributable to the Moorhead #1-13 well from 80 acres to 40 acres. I spoke with Lou Von Feltd yesterday and she suggested that I initiate a letter accompanied by Form CO-7 which corresponds to dedication of attributable acreage to a well for your review and approval. It is my understanding, based on my conversation with yourself and Ms. Von Feltd, that such a change for the Lahey Field, in which the Moorhead #1-13 well is located, would not pose a problem.

If you have any questions upon your review of this correspondence and Form, please give me a call at (806) 378-1000, Ext. 1280 or write to me at the address indicated below. Thank you for all your assistance in this matter.

Very truly yours,

Deana R. Rea
Operations Services

drr

Encl

FEB 11 1993

CO-7

CONSERVATION DIVISION
WICHITA, KS

PLAT AND CERTIFICATION OF ACREAGE ATTRIBUTABLE TO AN OIL WELL



State Corporation Commission, Conservation Division
200 Colorado Derby Bldg. Wichita, Kansas 67202

OPERATOR MESA OPERATING LIMITED PARTNERSHIP
LEASE NAME MOORHEAD
WELL NUMBER 1-13
FIELD LAHEY
NUMBER OF ACRES ATTRIBUTABLE TO WELL 40

LOCATION OF WELL:
510 feet north of SW corner
510 feet west of SW corner
Sec. 13 T. 31S R. 35W
COUNTY STEVENS

PLAT

(Show location of well and shade attributable acreage)
(Show footage to nearest lease or unit boundary line)

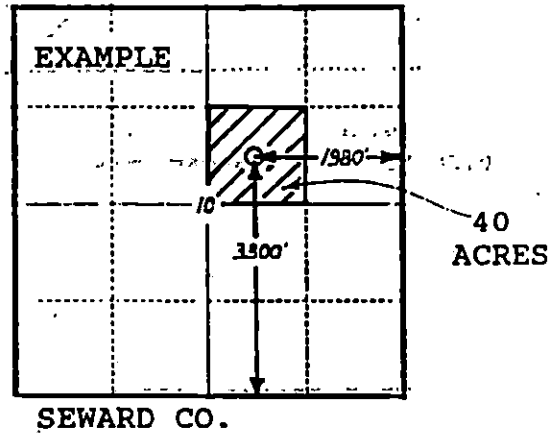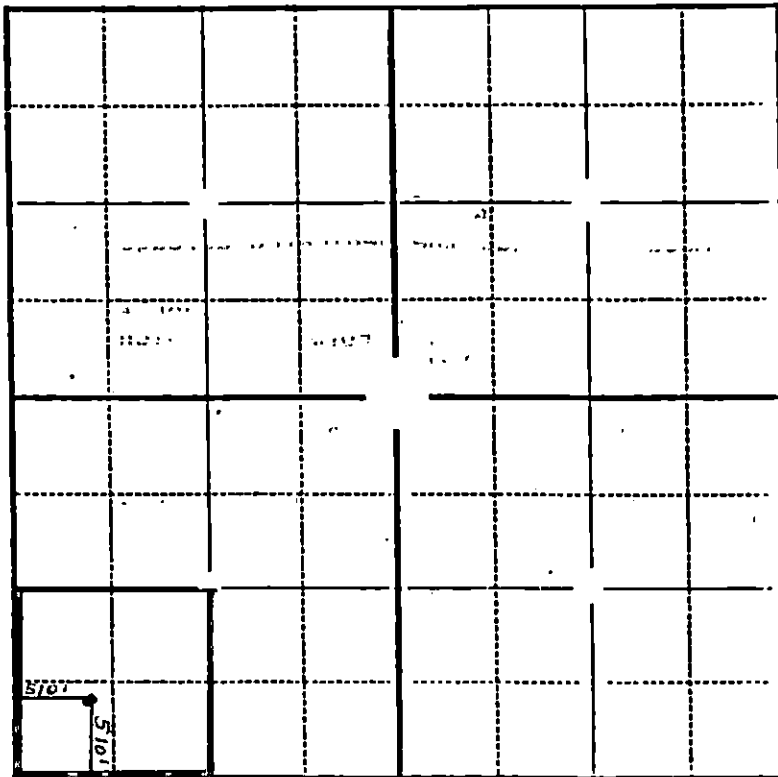

The undersigned hereby certifies that he is ADMINISTRATIVE CLERK
for MESA OPERATING LIMITED PARTNERSHIP (Co.), a duly authorized agent, that all
information shown hereon is true and correct to the best of his knowledge and
belief, and that all acreage claimed as attributable to the well named herein
is held by production from that well.

Subscribed and sworn to before me on this 10th day of February, 1993

Tammy Elliott
Notary Public

My Commission expires 5-24-93

(6-1989)

