

This form shall be filed in duplicate with the Kansas Corporation Commission, 200 Colorado Derby Building, Wichita, Kansas 67202, within ten days after the completion of the well, regardless of how the well was completed.

Attach separate letter of request if the information is to be held confidential. If confidential, only file one copy. Information on side one will be of public record and side two will then be held confidential.

Circle one: Oil, Gas, Dry, SWD, OWWO, Injection. Type and complete ALL sections. Applications must be filed for dual completion, commingling, SWD and injection.

Attach wireline logs (i.e. electrical log, sonic log, gamma ray neutron log, etc.). KCC # (316) 263-3238. (Rules 82-2-105 & 82-2-125)

OPERATOR R.J. PATRICK OPERATING COMPANY

API NO. 15-129-20-625-00-00

ADDRESS P.O. BOX 1314 Liberal, Ks 67901

COUNTY Morton

FIELD InterState

**CONTACT PERSON R. J. Patrick / Jack Taylor PHONE 316-624-8483

PROD. FORMATION Red Cave

PURCHASER Panhandle Eastern PipeLine

LEASE Lendcut

ADDRESS 117 E. 11th Liberal, Ks 67901

WELL NO. 6

WELL LOCATION SW SW NE - 33-34-43


2310 Ft. from North Line and

2310 Ft. from East Line of

the SEC. 33 TWP. 34 RGE. 43W

DRILLING CONTRACTOR KTM Drilling, Inc. ADDRESS P. O. Box 1385 Guymon, Okla

WELL PLAT

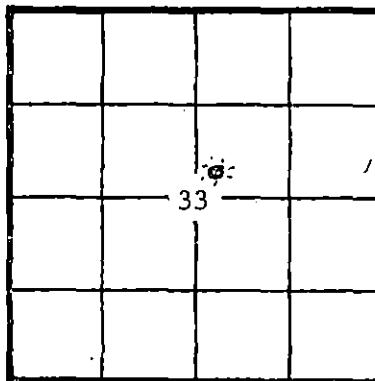

KCC [check] KGS [check] (Office Use)

PLUGGING N/A CONTRACTOR ADDRESS

TOTAL DEPTH 1263' PBTD

SPUD DATE 4/5/82 DATE COMPLETED 4/17/82

ELEV: GR 3,540' DF KB 3544'

DRILLED WITH (CABLE) (ROTARY) (AIR) TOOLS

Amount of surface pipe set and cemented 1263' DV Tool Used? yes

AFFIDAVIT

STATE OF Kansas, COUNTY OF Seward SS, I, Elmer

Jack Taylor OF LAWFUL AGE, BEING FIRST DULY SWORN UPON HIS OATH,

DEPOSES THAT HE IS Operator (FOR)(OF) R.J. PATRICK OPERATING COMPANY

OPERATOR OF Lendcut LEASE, AND IS DULY AUTHORIZED TO MAKE

THIS AFFIDAVIT FOR AND ON THE BEHALF OF SAID OPERATOR, THAT WELL NO. 6 ON

SAID LEASE HAS BEEN COMPLETED AS OF THE 17th DAY OF April, 19 82, AND THAT

ALL INFORMATION ENTERED HEREIN WITH RESPECT TO SAID WELL IS TRUE AND CORRECT.

FURTHER AFFIANT SAITH NOT.

RECEIVED STATE CORPORATION COMMISSION APR 20 1982 CONSERVATION DIVISION Wichita, Kansas

(S) Elmer Jack Taylor

SUBSCRIBED AND SWORN BEFORE ME THIS 26 DAY OF April, 19 82.

MARNELL PRIBBLE Seward County, Kansas My Appt. Expires 8-20-83 MY COMMISSION EXPIRES: 8-20-83

Marnell Pribble NOTARY PUBLIC

**The person who can be reached by phone regarding any questions concerning this information. Within 45 days of completion, a witnessed initial test by the Commission is required if the well produces more than 25 BOPD or is located in a Basic Order Pool.

SIDE TWO

WELL LOG

Show all important zones of porosity and contents thereof; cored intervals; and all drill-stem tests, including depth interval tested, cushion used, time tool open, flowing and shut-in pressures, and recoveries.

SHOW GEOLOGICAL MARKERS, LOGS RUN, OR OTHER DESCRIPTIVE INFORMATION.

FORMATION DESCRIPTION, CONTENTS, ETC.	TOP	BOTTOM	NAME	DEPTH
Surface Sand Clay Shale	0	410		
Clay Shale	410	700		
Clay and Anhyd	700	826		
Clay Shale Glor.	826	1250		
Shale & Stone	1250	1263		
Red Cave	1263			

Report of all strings set — surface, intermediate, production, etc. **CASING RECORD** (New) or (Used)

Purpose of string	Size hole drilled	Size casing set (in O.D.)	Weight lbs/ft.	Setting depth	Type cement	Sacks	Type and percent additives
Surface	12 1/4"	8 5/8"	20#	410'	H Halliburton	275	3% cc 1/4# Flocele
Production	7 7/8"	4 1/2"	9 1/2#	1263'	HCL Pozmix	350 50	2% cc 1/4# Flocele

LINER RECORD

PERFORATION RECORD

Top, ft.	Bottom, ft.	Sacks cement	Shots per ft.	Size & type	Depth interval
none					

TUBING RECORD

Size	Setting depth	Packer set at
None		

ACID, FRACTURE, SHOT, CEMENT SQUEEZE RECORD

Amount and kind of material used	Depth interval treated
None Open Hole Completion No treatment	

Date of first production 4-17-82	Producing method (flowing, pumping, gas lift, etc.) Flowing	Gravity
RATE OF PRODUCTION PER 24 HOURS Oil 0 bbls.	Gas 100' MCF	Water 0 % 0 bbls.
Disposition of gas (vented, used on lease or sold)		Perforations
		CFPB