

This form shall be filed in duplicate with the Kansas Corporation Commission, 200 Colorado Derby building, Wichita, Kansas 67202, within ten days after the completion of the well, regardless of how the well was completed.

Attach separate letter of request if the information is to be held confidential. If confidential, only file one copy. Information on side one will be of public record and side two will then be held confidential.

Circle one: Oil, Gas, Dry, SWD, OWWO, Injection. Type and complete ALL sections.

Applications must be filed for dual completion, commingling, SWD and injection, T.A.

X Attach wireline logs (i.e. electrical log, sonic log, gamma ray neutron log, etc.).

KCC # (316) 263-3238. (Rules 82-2-105 & 82-2-125)

OPERATOR Anadarko Production Company

API NO. 15-129-20,565-00-00

ADDRESS P. O. Box 351

COUNTY Morton

Liberal, Kansas 67901

FIELD Interstate Purdy Morrow

**CONTACT PERSON Mr. Paul Gatlin

PROD. FORMATION Purdy Morrow

PHONE 316-624-6253

LEASE INTERSTATE UNIT

PURCHASER National Co-op

WELL NO. 95

ADDRESS _____

WELL LOCATION 1320' FNL & 96' FEL

1320 Ft. from North Line and

96 Ft. from East Line of

the NE/4 SEC. 29 TWP. 34S RGE. 43W

DRILLING Wakefield Drilling Company

CONTRACTOR _____

ADDRESS 300 West Douglas, Suite 500

Wichita, Kansas 67202

PLUGGING _____

CONTRACTOR _____

ADDRESS _____

TOTAL DEPTH 4281 PBD 4241


SPUD DATE 11/13/81 DATE COMPLETED 1/16/82

ELEV: GR 3485' DF 3491' KB 3492'

DRILLED WITH (CABLE) (ROTARY) (AIR) TOOLS

Amount of surface pipe set and cemented 1193' DV Tool Used? No

WELL PLAT

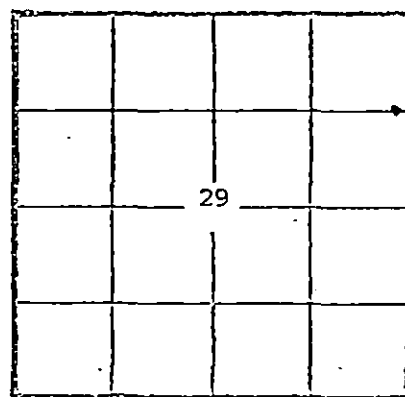

KCC
KGS
(Office Use)

AFFIDAVIT

STATE OF KANSAS, COUNTY OF SEWARD SS, I, Paul

Campbell OF LAWFUL AGE, BEING FIRST DULY SWORN UPON HIS OATH,

DEPOSES THAT HE IS Division Operations Manager (FOR)(OF) Anadarko Production Company

OPERATOR OF THE INTERSTATE UNIT LEASE, AND IS DULY AUTHORIZED TO MAKE

THIS AFFIDAVIT FOR AND ON THE BEHALF OF SAID OPERATOR, THAT WELL NO. 95 ON

SAID LEASE HAS BEEN COMPLETED AS OF THE 16th DAY OF January, 19 82, AND THAT

ALL INFORMATION ENTERED HEREIN WITH RESPECT TO SAID WELL IS TRUE AND CORRECT.

FURTHER AFFIANT SAITH NOT.

(Signature of Paul Campbell)

(S) Paul Campbell

SUBSCRIBED AND SWORN BEFORE ME THIS _____ DAY OF _____, 19 _____.

(Signature of Notary Public)

NOTARY PUBLIC

MY COMMISSION EXPIRES: _____

**The person who can be reached by phone regarding any questions concerning this information. Within 45 days of completion, a witnessed initial test by the Commission is required if the well produces more than 25 BOPD or is located in a Basic Order Pool.

WELL LOG

SHOW GEOLOGICAL MARKERS, LOGS RUN, OR OTHER DESCRIPTIVE INFORMATION.

Show all important zones of porosity and contents thereof; cased intervals, and all drill-stem tests, including depth interval tested, cushion used, time tool down, flowing and shut-in pressures, and recoveries.

FORMATION DESCRIPTION, CONTENTS, ETC.	TOP	BOTTOM	NAME	DEPTH
Clay & Gyp	0'	550'	LOGS: Gearhart Compensated Density-Compensated Neutron Log Dual Induction Laterlog	
Redbed & Gyp	550'	825'		
Sand	825'	945'		
Redbed & Gyp	945'	958'		
Redbed & Gyp, Anhydrite	958'	1195'		
Anhydrite & Shale	1195'	1550'		
Redbed & Shale	1550'	2310'		
Shale & Line Streaks	2310'	2522'		
Lime & Shale	2522'	2593'		
Shale	2593'	2659'		
Lime & Shale	2659'	4281'		
RTD		4281'		

Report of all strings set — surface, intermediate, production, etc. CASING RECORD (New) or (Used)

Purpose of string	Size hole drilled	Size casing set (in O.D.)	Weight lbs/ft.	Setting depth	Type cement	Sacks	Type and percent additives
Surface	12-1/4"	8-5/8"	24#	1193'	Pozmix	450	2% CaCl
					Common	200	3% CaCl
Production	7-7/8"	5-1/2"	15.5#	4280	Lite-wate	50	.5% Tic
					SS Pozmix	125	.5% Tic

LINER RECORD

PERFORATION RECORD

Top, ft.	Bottom, ft.	Sacks cement	Shots per ft.	Size & type	Length interval
			2	.46	4105-20' C.A.

TUBING RECORD

Size	Setting depth	Packer set at
2-7/8"	4009	None

ACID, FRACTURE, SHOT, CEMENT SQUEEZE RECORD

Amount and kind of material used	Depth interval treated
NONE	

Date of first production 1/16/82	Producing method (flowing, pumping, gas lift, etc.) Pumping	Gravity 38.5 @ 60°
RATE OF PRODUCTION PER 24 HOURS	Oil 6 bbls.	Gas t.s.t.m. MCF
	Water 291 bbls.	Gas-oil ratio CFPP
Disposition of gas (vented, used on lease or sold) To be sold		Perforations 4105-20' C.A. (Purdy Marrow)