


Give All Information Completely
Make Required Affidavit
Mail or Deliver Report to:
Conservation Division
State Corporation Commission
211 No. Broadway
Wichita, Kansas

WELL PLUGGING RECORD

Kingman County. Sec. 32 Twp. 29 Rge. 9 (E) W (W)

Location as "NE/CNW/SW" or footage from lines NE NW
Lease Owner Morgenstern & Specter, Inc.
Lease Name Heibsch Well No. 2
Office Address Russell, Kansas
Character of Well (completed as Oil, Gas or Dry Hole)
Date well completed 19
Application for plugging filed 19
Application for plugging approved 19
Plugging commenced 1-21-63 19
Plugging completed 1-26-63 19
Reason for abandonment of well or producing formation Depleted.

NORTH

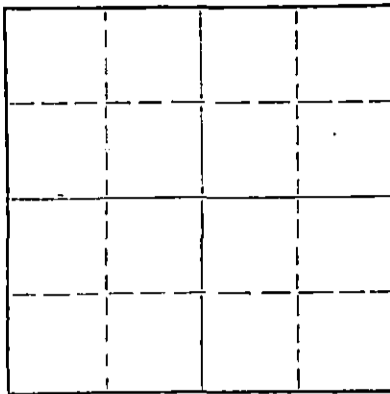

Locate well correctly on above
Section Plat

If a producing well is abandoned, date of last production 19
Was permission obtained from the Conservation Division or its agents before plugging was commenced? yes

Name of Conservation Agent who supervised plugging of this well Archie Elving
Producing formation _____ Depth to top _____ Bottom _____ Total Depth of Well 4433 Feet
Show depth and thickness of all water, oil and gas formations.

OIL, GAS OR WATER RECORDS

CASING RECORD

FORMATION	CONTENT	FROM	TO	SIZE	PUT IN	PULLED OUT
				8-5/8"	398'	None
				5-1/2"	4437'	3493'

Describe in detail the manner in which the well was plugged, indicating where the mud fluid was placed and the method or methods used in introducing it into the hole. If cement or other plugs were used, state the character of same and depth placed, from _____ feet to _____ feet for each plug set.

Checked hole to 4206', sanded to 4145' and dumped 5 sacks of cement @ 4145' with dump bailer. Pulled 5 1/2" casing, mudded hole to 200', set rock bridge to 190' and ran 20 sacks of cement @ 190'. Mudded to 40', set rock bridge to 30' and ran 10 sacks of cement to base of cellar.

PLUGGING COMPLETE.

RECEIVED
STATE CORPORATION COMMISSION
FEB 4 1963
CONSERVATION DIVISION
Wichita, Kansas

(If additional description is necessary, use BACK of this sheet)
Name of Plugging Contractor KNIGHT CASING PULLING COMPANY
Address CHASE, KANSAS

STATE OF KANSAS, COUNTY OF RICE, ss.
Noel J. Knight (employee of owner) or (owner or operator) of the above-described well, being first duly sworn on oath, says: That I have knowledge of the facts, statements, and matters herein contained and the log of the above-described well as filed and that the same are true and correct. So help me God.

(Signature) Noel J. Knight
Chase, Kansas
(Address)

SUBSCRIBED AND SWORN to before me this 31st day of January, 1963
Milton J. Volin
Notary Public.

My commission expires May 20, 1964



- 15-095-00579-0000
 WELL LOG BUREAU—KANSAS GEOLOGICAL SOCIETY
 508 East Murdock, Wichita, Kansas


COPY

Company- CITIES SERVICE OIL CO.
 Farm- Hiebsch No. 2

SEC. 32 T. 29 R. 9W
 NE SW NW
 1650' S & 990' E of NW corne

Total Depth. 4440' PB 4206'
 Comm. 10-9-57 Comp. 10-25-57
 Shot or Treated.
 Contractor. Barbour Drlg.
 Issued. 6-21-58

County Kingman
 KANSAS /

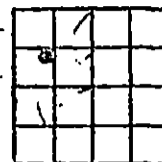

Elevation. 1616' Gr.
 Production. 1,476,000 CFG

CASING:

8 5/8" 402' cem w/275 sx.
 5 1/2" 4433' cem w/150 sx.

Figures indicate Bottom of Formations.

clay	20
clay & sand	140
red bed	402
red bed, shale & shells	1030
shale	1350
anhydrite	1530
shale & lime	1730
lime & shale	1795
lime	1865
lime & shale	2475
shale & lime	2615
lime & shale	2825
shale & lime	2985
lime & shale	3080
shale & lime	3215
lime	3315
sandy lime & shale	3409
sand & shale	3500
shale & lime	3580
lime	3980
lime & shale	4100
shale & lime	4150
lime & shale	4160
chert	4190
chert & shale	4200
lime	4217
lime & shale	4295
shale & lime	4395
lime & shale	4400
lime	4440

4440 RTD = 4433 SLM

Total Depth
 Plugged back to 4206'

TOPS: CORR.

Heebner	3328
Dodge	3340
Douglas	3360
Lansing	3540
Base Kansas City	3973
Mississippi	4153
Kinderhook	4226
Viola	4397
Pen.	36'

Perf. 6 shots 4396-98, 102' fluid in 1 hr.
 5 mins. 140' fluid in 1 hr. 20 mins.

Perf. 102 shots 4156-73; 140 MCF gas.
 11-13-57 Frac w/4000# sand & 6400 gals.
 jel acid in 7 mins, treating pressure
 2400-1900#.

11-4-57 Acidized 100 gals. 4396-98.

JAN 10 1963
 CONSERVATION DIVISION
 Wichita, Kansas