

15-095-01299-0000


STATE OF KANSAS
STATE CORPORATION COMMISSION
Give All Information Completely
Make Required Affidavit
Mail or Deliver Report to:
Conservation Division
State Corporation Commission
211 No. Broadway
Wichita, Kansas

WELL PLUGGING RECORD

KINGMAN County. Sec. 34 Twp. 29 Rge. 9 (W) (W)

Location as "NE/CNW&SW&" or footage from lines C SE NW
Lease Owner PETROLEUM INC.
Lease Name BOHRER "F" Well No. 1
Office Address Route 2, Great Bend, Kansas
Character of Well (completed as Oil, Gas or Dry Hole) Dry Hole
Date well completed April 22 19 58
Application for plugging filed April 23 19 58
Application for plugging approved April 22 19 58
Plugging commenced April 22 19 58
Plugging completed April 22 19 58
Reason for abandonment of well or producing formation No Produccible Zones

NORTH

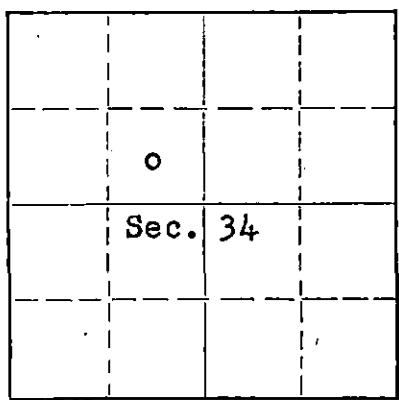

Locate well correctly on above Section Plat

If a producing well is abandoned, date of last production None 19
Was permission obtained from the Conservation Division or its agents before plugging was commenced? Yes

Name of Conservation Agent who supervised plugging of this well Fred W. Hampel, Pretty Prairie, Kansas
Producing formation ----- Depth to top --- Bottom ----- Total Depth of Well 4308 Feet
Show depth and thickness of all water, oil and gas formations.

OIL, GAS OR WATER RECORDS

CASING RECORD

FORMATION	CONTENT	FROM	TO	SIZE	PUT IN	PULLED OUT
				8-5/8"	278'	None

Describe in detail the manner in which the well was plugged, indicating where the mud fluid was placed and the method or methods used in introducing it into the hole. If cement or other plugs were used, state the character of same and depth placed, from _____ feet to _____ feet for each plug set.

Mud up with heavy mud to 260' followed by wooden plug. Placed 10 sacks cement through drill pipe on to plug. Mud up to 35' followed by wooden plug and 10 sacks cement to base of well cellar.

(If additional description is necessary, use BACK of this sheet)
Name of Plugging Contractor Garvey Drilling Co.
Address Route 2, Great Bend, Kansas

STATE OF Kansas, COUNTY OF Barton, ss.
Don Searle (employee of owner) or (owner or contractor) of the above-described well, being first duly sworn on oath, says: That I have knowledge of the facts, statements, and matters herein contained and the log of the above-described well as filed and that the same are true and correct. So help me God.

(Signature) Don Searle
Route 2, Great Bend, Kansas (Address)

SUBSCRIBED AND SWORN TO before me this 29th day of April 19 58

My commission expires July 11, 1960

Jed B. Bason Notary Public.
RECEIVED STATE CORPORATION COMMISSION

PLUGGING
FILED SEC 34 T. 29 R. 9
BOOK PAGE 94 LINE 9

APR 30 1958 4-30-1958
CONF. WICHITA

15-095-01299-0000
WELL LOG

COMPANY PETROLEUM, INCORPORATED

SEC. 34 T. 29S R. 9W

FARM BOHRER "F" NO. 1

LOC. C-SE, NW


TOTAL DEPTH 4308'

COUNTY KINGMAN CO., KANSAS

COMM. April 9, 1958

COMP. April 22, 1958

CONTRACTOR GARVEY DRILLING COMPANY

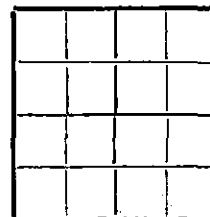

CASING 8 5/8" @ 278' W/175 sax.

ELEVATION 1619' DF

PRODUCTION KD & A

FIGURES INDICATE BOTTOM OF FORMATIONS

100	Red bed & shells
1170	Shale & red bed
1541	Shale, shells & sand
2032	Lime & shale
2595	Shale
3166	Lime & shale
3346	Lime
3540	Shale & lime
4012	Lime
4112	Lime & shale
4196	Lime
4220	Shale & lime
4280	Lime
4308	Lime & shale
4308	T. D.

RECEIVED
STATE COMMISSION

APR 30 1958

CONCRETE DIVISION
Wichita, Kansas

State of KANSAS
County of BARTON } ss:

PLUGGING
FILE SEC. 34 T. 29 R. 9 W.
BOOK PAGE 96 LINE 9

I, VERNE A. MORRIS of GARVEY DRILLING COMPANY

upon oath state that the above and foregoing is a true and correct copy of the log of the #1 BOHRER "F" well

Verne A. Morris

Subscribed and sworn to before me this 29th day of April 1958

My Commission Expires: July 11, 1960

[Signature]
NOTARY PUBLIC