


Give All Information Completely
Make Required Affidavit
Mail or Deliver Report to:
Conservation Division
State Corporation Commission
211 No. Broadway
Wichita, Kansas

WELL PLUGGING RECORD

NORTH

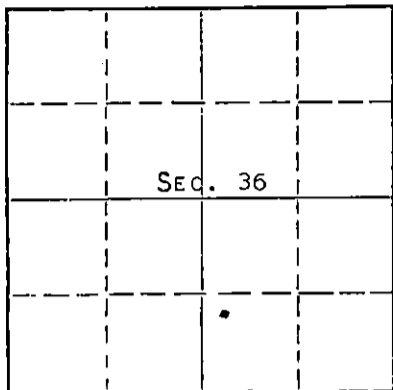

Locate well correctly on above
Section Plat

KINGMAN County. Sec. ³⁶~~26~~ Twp. 29s Rge. XX (E) 9 (W)
Location as "NE/CNW/SW" or footage from lines NW SW SE
Lease Owner PETROLEUM, INC.
Lease Name HARTSHORN Well No. 1
Office Address ROUTE 2, GREAT BEND, KANSAS
Character of Well (completed as Oil, Gas or Dry Hole) DRY HOLE
Date well completed OCTOBER 10 19 64
Application for plugging filed OCTOBER 10 19 64
Application for plugging approved OCTOBER 10 19 64
Plugging commenced OCTOBER 10 19 64
Plugging completed OCTOBER 10 19 64
Reason for abandonment of well or producing formation NO PRODUCIBLE ZONES

If a producing well is abandoned, date of last production NONE 19
Was permission obtained from the Conservation Division or its agents before plugging was commenced? YES

Name of Conservation Agent who supervised plugging of this well ARCHIE FLYING
Producing formation _____ Depth to top _____ Bottom _____ Total Depth of Well 4204 Feet
Show depth and thickness of all water, oil and gas formations.

OIL, GAS OR WATER RECORDS

CASING RECORD

FORMATION	CONTENT	FROM	TO	SIZE	PUT IN	PULLED OUT
				8-5/8	252'	NONE

Describe in detail the manner in which the well was plugged, indicating where the mud fluid was placed and the method or methods used in introducing it into the hole. If cement or other plugs were used, state the character of same and depth placed, from _____ feet to _____ feet for each plug set.

MUDDED UP WITH HEAVY MUD TO 250', FOLLOWED BY WOODEN PLUG AND 1/4 SACK HULLS. PLACED 25 SACKS CEMENT THROUGH DRILL PIPE ONTO HULLS. MUDDED UP WITH HEAVY MUD TO 40', FOLLOWED BY WOODEN PLUG, 1/2 SACK HULLS AND 10 SACKS CEMENT TO BASE OF WELL CELLAR. PLUG RAT HOLE WITH 2 SACKS CEMENT

RECEIVED
STATE CORPORATION COMMISSION

OCT 14 1964 10-14-1964

CONSERVATION DIVISION
Wichita, Kansas

(If additional description is necessary, use BACK of this sheet)

Name of Plugging Contractor GARVEY DRILLING COMPANY
Address ROUTE 2, GREAT BEND, KANSAS

STATE OF KANSAS, COUNTY OF BARTON, ss.
MONTE CHADD (employee of owner) or (owner/operator) of the above-described well, being first duly sworn on oath, says: That I have knowledge of the facts, statements, and matters herein contained and the log of the above-described well as filed and that the same are true and correct. So help me God. MONTE CHADD, DIST. PROD. SUPT.
(Signature) Monte Chadd
ROUTE 2, GREAT BEND, KANSAS (Address)

SUBSCRIBED AND SWORN to before me this 13TH day of OCTOBER, 19 64

My commission expires APRIL 14, 1967 Archer J. Wiles Notary Public.

15-095-19140-0000
WELL LOG

COMPANY Petroleum, Inc.

SEC. 36 T. 29S R. 9W

FARM Hartshorn NO. 1


LOC. NW SW SE

TOTAL DEPTH 4204'

COUNTY Kingman

COMM. 9-30-64 COMP. 10-10-64

CONTRACTOR Garvey Drilling Company

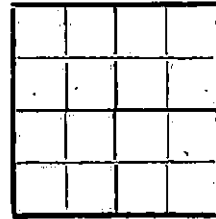

CASING 8 5/8" @ 252' w/200 sx

ELEVATION 1590' K.B.

PRODUCTION D & A

FIGURES INDICATE BOTTOM OF FORMATIONS

- 40' Hard Sand
- 140' Hard Sand and Red Bed
- 252' Red Rock and Shale
- 850' Red Bed and Shale
- 1260' Shale and Shells
- 1420' Shale and Lime
- 2025' Lime
- 2260' Shale and Sandy Lime
- 2900' Lime and Shale
- 2945' Shale and Lime
- 3164' Lime
- 3323' Lime and Shale
- 3377' Shale
- 3494' Lime and Shale
- 4084' Lime
- 4147' Shale and Lime
- 4169' Lime
- 4204' Mississippi Chat.
- 4204' RTD

RECEIVED
STATE CORPORATION COMMISSION

OCT 14 1964

CONSERVATION DIVISION
Wichita, Kansas

State of Kansas
County of Barton } SS

I, Sam N. Stephens of Garvey Drilling Company
upon oath state the above and foregoing is a true and correct copy of the log of the Hartshorn #1 well.

Sam N. Stephens

Subscribed and sworn to before me this 12th day of October 19 64

My Commission Expires: April 14th, 1967

Arthur J. Wiles
NOTARY PUBLIC