
15-095-00348-0000

STATE OF KANSAS
STATE CORPORATION COMMISSION

Give All Information Completely
Make Required Affidavit
Mail or Deliver Report to:
Conservation Division
State Corporation Commission
212 North Market, Insurance Bldg.
Wichita, Kansas

WELL PLUGGING RECORD

NORTH

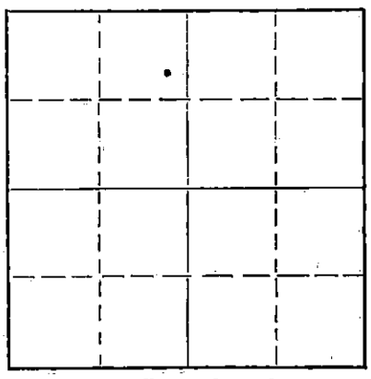

Locate well correctly on above Section Plat

Kingman County. Sec. 36 Twp. 29S Rge. ____ (E) 9 (W)

Location as "NE/CNW¼SW¼" or footage from lines SW NW NE

Lease Owner Pickrell Drilling Company

Lease Name Hartshorn Well No. 1

Office Address 705 Fourth National Bank Bldg., Wichita, Kansas

Character of Well (completed as Oil, Gas or Dry Hole) Dry Hole

Date well completed 2-5 19 59

Application for plugging filed 2-5 19 59

Application for plugging approved 2-5 19 59

Plugging commenced 2-5 19 59

Plugging completed 2-5 19 59

Reason for abandonment of well or producing formation Dry & Abandoned

If a producing well is abandoned, date of last production ____ 19____

Was permission obtained from the Conservation Division or its agents before plugging was commenced? Yes

Name of Conservation Agent who supervised plugging of this well W. L. LacKamp

Producing formation ____ Depth to top ____ Bottom ____ Total Depth of Well 4305 Feet

Show depth and thickness of all water, oil and gas formations.

OIL, GAS OR WATER RECORDS — CASING RECORD

FORMATION	CONTENT	FROM	TO	SIZE	PUT IN	PULLED OUT
				8 5/8"	250'	None

Describe in detail the manner in which the well was plugged, indicating where the mud fluid was placed and the method or methods used in introducing it into the hole. If cement or other plugs were used, state the character of same and depth placed, from ____ feet to ____ feet for each plug set.

Filled with heavy mud to 240', bridge hole and cement with 20 sacks cement. Then heavy mud to 35' below ground level, bridge hole and cement with 10 sacks cement to bottom of cellar.

RECEIVED
STATE CORPORATION COMMISSION
FEB 12 1959
CONSERVATION DIVISION
Wichita, Kansas

(If additional description is necessary, use BACK of this sheet)

Name of Plugging Contractor Pickrell Drilling Company

Address 705 Fourth National Bank Bldg., Wichita 2, Kansas

STATE OF Kansas, COUNTY OF Sedgwick, ss.

C. W. Sebits (employee of owner) or (owner or operator) of the above-described well, being first duly sworn on oath, says: That I have knowledge of the facts, statements, and matters herein contained and the log of the above-described well as filed and that the same are true and correct. So help me God.

(Signature) C. W. Sebits

705 Fourth Nat'l Bank Bldg., Wichita, Kansas
(Address)

SUBSCRIBED AND SWORN TO before me this 11th day of February, 1959

Mary Ellen Sampson
(Mary Ellen Sampson) Notary Public.

My commission expires: May 13, 1962

PLUGGING
FILE SEC 36 T 29 R 9W
BOOK PAGE 17 LINE 5

5411

15-095-00348-0000

ROTARY DRILLING LOG

COMPANY: Pickrell Drilling Company

Rotary Drilling Commenced 1/23/59

Rotary Drilling Completed 2/5/59

LOCATION: SW NW NE, Sec. 36-29S-9W,
Kingman, County, Kansas

Hartshorn #1

CONTRACTOR: PICKRELL DRILLING COMPANY
Wichita, Kansas

CASING RECORD: 250' (6 jts.) 8 5/8" 22.7# Armco Spiralweld Casing cemented with 150 sacks cement, 2% Gel. Cement circulated.

D&A, No oil string run

L O G

(Figures indicate bottom of formation — measurements from top of rotary bushing.)

Sand & Clay	50'	Circ. for samples 4255'
Red Rock	250'	4265'
Red Rock & Shale	810'	4305'
Lime & Shale	1390'	
Lime	1610'	
Lime & Shale	1905'	
Lime	2030'	
Lime & Shale	3085'	
Lime	3280'	
Lime, Shale & Sand	3585'	
Lime	4000'	
Lime & Shale	4250'	
Mississippi	4305' T.D.	

S.L.M. at 2000 - OK
3000 - OK
4000 - OK

Slope Test at 2000 0° off
3000 0° off
4000 0° off

RECEIVED
STATE CORPORATION COMMISSION
FEB 12 1959
CONSERVATION DIVISION

PLUGGING
FILE SEC 36 T 29 R 9W
BOOK PAGE 17 LINE 5

The undersigned, C. W. Sebits, Attorney-in-Fact for PICKRELL DRILLING COMPANY, hereby certifies in behalf of said Company, that the above is a true and correct log of the formation encountered in drilling the above well as reflected by the Daily Drilling Reports.

PICKRELL DRILLING COMPANY

By _____
Attorney-in-Fact

STATE OF KANSAS, }
COUNTY OF SEDGWICK } ss.

On this 10th day of February, 19 59, before me the undersigned, a Notary Public, in and for the County and State aforesaid, personally appeared C. W. Sebits, to me known to be the identical person who subscribed the name of PICKRELL DRILLING COMPANY to the foregoing instrument as its Attorney-in-Fact and acknowledged to me that he executed the same as his free and voluntary act and deed, and as the free and voluntary act and deed of such company, for the uses and purposes therein set forth.

Given under my hand and seal of office the day and year last above written.

My commission expires: May 13, 1962

_____
Notary Public
(Mary Ellen Sampson)