

Sent 3/22/82

Rec'd
10-4-83

This form shall be filed in duplicate with the Kansas Corporation Commission, 200 Colorado Derby Building, Wichita, Kansas 67202, within ten days after the completion of the well, regardless of how the well was completed.

Attach separate letter of request if the information is to be held confidential. If confidential, only file one copy. Information on side one will be of public record and side two will then be held confidential.

Circle one: (11) Gas, Dry, SWD, OWWO, Injection. Type and complete ALL sections. Applications must be filed for dual completion, commingling, SWD and injection, T.A.

Attach wireline logs (i.e. electrical log, sonic log, gamma ray neutron log, etc.). KCC # (316) 263-3238. (Rules 82-2-105 & 82-2-125)

OPERATOR Drillers & Producers

API NO. 15-115-20800-0000

ADDRESS Box 385

COUNTY Marion

Newton, Kansas 67114

FIELD Burton Watchorn

**CONTACT PERSON E. A. Berry

PROD. FORMATION Hunton

PHONE ~~(316) 263-2830~~ 316, 283

LEASE Ammeter #2

PURCHASER Total Petroleum

WELL NO. 2

ADDRESS 999 18th St.,

WELL LOCATION SW- NW- SW/4

Denver Colo. 80202

DRILLING Kansas Drilling & Well Serv., Inc.

CONTRACTOR

ADDRESS Box 254

185' Ft. from West Line and

1540' Ft. from South Line of

Marion, Kansas 66861


the XXA SEC. 14 TWP. 22S RGE. 4E

WELL PLAT

PLUGGING

CONTRACTOR

ADDRESS

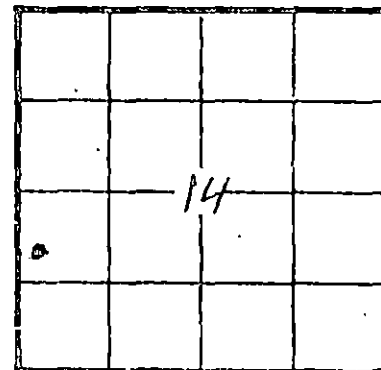

KCC _____
KGS _____
(Office Use)

TOTAL DEPTH 2589' PBTD 2585'

SPUD DATE 3-3-82 DATE COMPLETED 3-8-82

ELEV: GR _____ DF _____ KB _____

DRILLED WITH (CABLE) (ROTARY) (AIR) TOOLS

Amount of surface pipe set and cemented 181'KB DV Tool Used? NO

AFFIDAVIT

STATE OF Kansas, COUNTY OF Harvey SS, I, _____

Ernest A. Berry OF LAWFUL AGE, BEING FIRST DULY SWORN UPON HIS OATH,

DEPOSES THAT HE IS President (FOR)(OF) Drillers & Producers, Inc.,

OPERATOR OF THE Ammeter LEASE, AND IS DULY AUTHORIZED TO MAKE

THIS AFFIDAVIT FOR AND ON THE BEHALF OF SAID OPERATOR, THAT WELL NO. #2 ON

SAID LEASE HAS BEEN COMPLETED AS OF THE 8th DAY OF March, 19 82, AND THAT

ALL INFORMATION ENTERED HEREIN WITH RESPECT TO SAID WELL IS TRUE AND CORRECT.

FURTHER AFFIANT SAITH NOT.

(S) _____

SUBSCRIBED AND SWORN BEFORE ME THIS 22nd DAY OF March, 19 82.

MY COMMISSION EXPIRES: April 7, 1985

Dorothy M. Talbert
NOTARY PUBLIC DOROTHY M. TALBERT
STATE NOTARY PUBLIC
HARVEY COUNTY, KANSAS
this info - 7-7-85

**The person who can be reached by phone regarding any questions concerning this information. Within 45 days of completion, a witnessed initial test by the Commission is required if the well produces more than 25 ROPD or is located in a Basic Order Pool.

SIDE TWO

WELL LOG

Show all important zones of porosity and contents thereof; cored intervals, and all drill-stem tests, including depth interval tested, cushion used, time tool open, flowing and shut-in pressures, and recoveries.

SHOW GEOLOGICAL MARKERS, LOGS RUN, OR OTHER DESCRIPTIVE INFORMATION.

FORMATION DESCRIPTION, CONTENTS, ETC.		TOP	BOTTOM	NAME	DEPTH
0-2230	lime, shale				
2230-2440	Lans. K.C.				
2440-2585	Kinderhook				
2585-2589	Viola				
2589	TD				

RECEIVED
 STATE CORPORATION COMMISSION
 OCT 4 1983
 CONSERVATION DIVISION
 Wichita, Kansas

Report of oil strings set — surface, intermediate, production, etc. CASING RECORD (New) or (Used)

Purpose of string	Size hole drilled	Size casing set (in O.D.)	Weight lbs/ft.	Setting depth	Type cement	Sacks	Type and percent additives
Surface	12 1/4"	8 5/8"		181'	Class A Common	150	3% CACL
Production		5 1/2"		2584'	60-40 Pozmix	25	

LINER RECORD

PERFORATION RECORD

Top, ft.	Bottom, ft.	Sacks cement	Shots per ft.	Size & type	Depth interval

TUBING RECORD

Size	Setting depth	Packer set at

ACID, FRACTURE, SHOT, CEMENT SQUEEZE RECORD

Amount and kind of material used	Depth interval treated

Date of first production	Producing method (flowing, pumping, gas lift, etc.)	Gravity
--------------------------	---	---------

RATE OF PRODUCTION PER 24 HOURS	Oil bbls.	Gas MCF	Water %	Gas-oil ratio bbls.	CFPB
---------------------------------	-----------	---------	---------	---------------------	------

Disposition of gas (vented, used on lease or sold)	Perforations
--	--------------