

15-095-19014-0000

STATE OF KANSAS
STATE CORPORATION COMMISSION


Give All Information Completely
Make Required Affidavit
Mail or Deliver Report to:
Conservation Division
State Corporation Commission
800 Bittling Building
Wichita, Kansas

WELL PLUGGING RECORD

Kingman County. Sec. 34 Twp. 29 Rge. 7 (E) W (W)

Location as "NE/CNW/SW" or footage from lines. NW NW SW
Lease Owner Mull Drilling Co., Inc.
Lease Name Walters Well No. 2
Office Address 670 N Fourth Natl. Bank Bldg. Wichita, Kansas
Character of Well (completed as Oil, Gas or Dry Hole) Dry Hole
Date well completed 4-8- 19 59
Application for plugging filed 4-8- 19 59
Application for plugging approved 4-8- 19 59
Plugging commenced 3:00 P. M. 4-8- 19 59
Plugging completed 4:30 P. M. 4-8- 19 59
Reason for abandonment of well or producing formation Dry Hole

NORTH

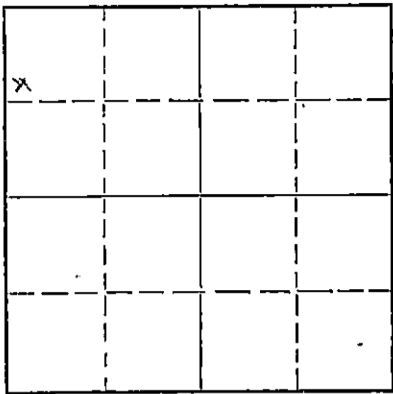

Locate well correctly on above
Section Plat

If a producing well is abandoned, date of last production None 19
Was permission obtained from the Conservation Division or its agents before plugging was commenced? Yes

Name of Conservation Agent who supervised plugging of this well Fred Hampel
Producing formation None Depth to top Bottom Total Depth of Well 4216 Feet
Show depth and thickness of all water, oil and gas formations.

OIL, GAS OR WATER RECORDS

CASING RECORD

FORMATION	CONTENT	FROM	TO	SIZE	PUT IN	PULLED OUT

Describe in detail the manner in which the well was plugged, indicating where the mud fluid was placed and the method or methods used in introducing it into the hole. If cement or other plugs were used, state the character of same and depth placed, from feet to feet for each plug set.

Hole was filled with drilling mud to depth of 180'. #1 Plug pushed to this depth. 1/2 sack hulls added to top of plug. 18 sacks cement put on top of hole through drill pipe #2 plug pushed to depth of 40'. 1/2 sack hulls put on top of plug 10 sacks cement put on top of hulls and plug completing plugging. 2 sacks cement put in rat hole to plug it.

RECEIVED
STATE CORPORATION COMMISSION
APR 15 1959
CONSERVATION DIVISION
Wichita, Kansas
4-15-1959

(If additional description is necessary, use BACK of this sheet)

Name of Plugging Contractor Company tools
Address

STATE OF KANSAS, COUNTY OF SEDGWICK, ss.
Joseph O. Butts (employee of owner) or (owner or operator) of the above-described well, being first duly sworn on oath, says: That I have knowledge of the facts, statements, and matters herein contained and the log of the above-described well as filed and that the same are true and correct. So help me God.

(Signature) Joseph O. Butts
(Address)

SUBSCRIBED AND SWORN to before me this 13th day of April, 1959
Ethel Zimmerman
Notary Public.

My commission expires January 28, 1961

PLUGGING
FILE SEC 34 T 29 R 7W
BOOK PAGE 30 LINE 25

ROTARY DRILLERS LOG

COMPANY: Mull Drilling Co., Inc. et al
Wichita, Kansas

ROTARY DRILLING COMMENCED: 3-26-59

CONTRACTOR: Mull Drilling Co., Inc.
Wichita, Kansas

ROTARY DRILLING COMPLETED: 4-8-59

CASING RECORD: Set 8 5/8" @ 204' w/ 150 sax cement
D & A

LOCATION: Walters #2
85' East NW/4 NW/4 SW/4 of
34-29S-7W
Kingman County, Kansas

(Figures indicate bottom of formation - measurements from top of Rotary Bushing.)

800'	Red Bed & Shale
1075'	Shale & Shells
1609'	Lime & Shale
1730'	Lime
3246'	Lime & Shale
3358'	Sandy Lime & Shale
3508'	Lime w/Shale
3713'	Lime
4095'	Lime & Shale
4170'	Mississippi
4216'	Cherty Dolomite (Total Depth)

RECEIVED
STATE CORPORATION COMMISSION
APR 15 1959
CONSERVATION DIVISION
Wichita, Kansas

I hereby certify that this is a true and correct copy of the above log to the best of my knowledge.

MULL DRILLING COMPANY, INC.

R. James Gear
R. James Gear

STATE OF KANSAS)
) SS
COUNTY OF SEDGWICK)

Subscribed and sworn to before me this 14th day of April, 1959



Madge N. Miller
Madge N. Miller, Notary Public

PLUGGING
FILE SEC 34 T 29 R 7W
BOOK PAGE 30 LINE 25

Commission Expires: February 24, 1960