


STATE OF KANSAS
STATE CORPORATION COMMISSION

Form CP-4

WELL PLUGGING RECORD

Give All Information Completely
Make Required Affidavit
Mail or Deliver Report to:
Conservation Division
State Corporation Commission
P. O. Box 17027
Wichita, Kansas 67217
NORTH

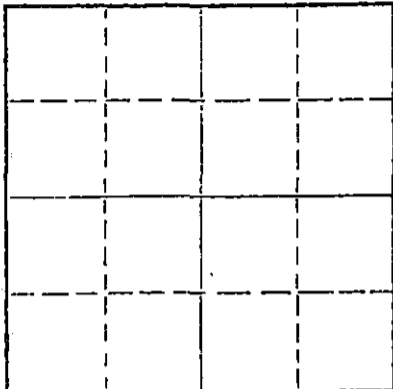

Locate well correctly on above
Section Plat

Kingman County, Sec. 8 Twp. 29S Rge. 6 (E) (W)
Location as "NE/CNW/SW" or footage from lines. C E/2 NE SE
Lease Owner Robert E. Campbell
Lease Name W. R. Pinkerton "A" Well No. 1
Office Address 417 South Glendale, Wichita, Kansas 67218
Character of Well (completed as Oil, Gas or Dry Hole) Dry Hole
Date well completed October 2, 19 72
Application for plugging filed October 2, 19 72
Application for plugging approved October 2, 19 72
Plugging commenced October 2, 19 72
Plugging completed October 2, 19 72
Reason for abandonment of well or producing formation

If a producing well is abandoned, date of last production 19
Was permission obtained from the Conservation Division or its agents before plugging was commenced? Yes

Name of Conservation Agent who supervised plugging of this well G. R. Biberstein, Attica, Kansas
Producing formation Depth to top Bottom Total Depth of Well 4122 Feet
Show depth and thickness of all water, oil and gas formations.

OIL, GAS OR WATER RECORDS

CASING RECORD

FORMATION	CONTENT	FROM	TO	SIZE	PUT IN	PULLED OUT
				8-5/8"	222'	None

Describe in detail the manner in which the well was plugged, indicating where the mud fluid was placed and the method or methods used in introducing it into the hole. If cement or other plugs were used, state the character of same and depth placed, from feet to feet for each plug set.
Mudded up with heavy mud to 220 feet. Followed by wooden plug, 1/2 sack hulls and 25 sacks cement. Mudded up to 40 feet followed by wooden plug, 1/2 sack hulls and 10 sacks of cement to base of well cellar. Plugged rat hole with 2 sacks cement.

RECEIVED
STATE CORPORATION COMMISSION
OCT 5 1972
CONSERVATION DIVISION
Wichita, Kansas

(If additional description is necessary, use BACK of this sheet)
Name of Plugging Contractor Graves Drilling Co., Inc.
Address 505 Union Center, Wichita, Kansas 67202

STATE OF KANSAS, COUNTY OF SEDGWICK, ss.
John C. Graves (employee of owner) or (owner or operator) of the above-described well, being first duly sworn on oath, says: That I have knowledge of the facts, statements, and matters herein contained and the log of the above-described well as filed and that the same are true and correct. So help me God.

(Signature) John C. Graves
505 Union Center, Wichita, Kansas 67202
(Address)

SUBSCRIBED AND SWORN to before me this 4th day of October, 19 72

Betty Brandt
Notary Public.

My commission expires May 9, 1975

ROTARY DRILLERS' LOG

OPERATOR: Robert E. Campbell DRILLING COMMENCED: September 27, 1972
417 South Glendale
Wichita, Kansas 67218

CONTRACTOR: Graves Drilling Co., Inc. DRILLING COMPLETED: October 2, 1972
505 Union Center
Wichita, Kansas 67202

CASING RECORD: 5 Jts. 222' of 8-5/8" LOCATION: W. R. Pinkerton "A" No. 1
cemented with 200 sacks C E/2 NE SE
Section 8-29S-6W
Kingman County, Kansas

0 - 45	Sand
45 - 223	Red bed
223 - 1060	Red bed & shale
1060 - 1255	Lime & shale
1255 - 1515	Shale with lime streaks
1515 - 1700	Shale
1700 - 2237	Lime & shale
2237 - 2666	Shale & lime
2666 - 2815	Lime & shale
2815 - 2950	Shale & lime
2950 - 3155	Lime & shale
3155 - 4060	Lime
4060 - 4091	Shale & lime
4091 - 4110	Chert
4110 - 4122	Lime
4122	Rotary Total Depth

RECEIVED
STATE CORPORATION COMMISSION
OCT 5 1972
CONSERVATION DIVISION
Wichita, Kansas

I hereby certify the foregoing statements to be true and correct to the best of my knowledge.

GRAVES DRILLING CO., INC.

By John Graves
President

STATE OF KANSAS)
) ss.
SHERIDAN COUNTY)

Subscribed and sworn to before me, a Notary Public, this 4th day of October, 1972.

Betty Brandt
Betty Brandt Notary Public

My commission expires:
May 9, 1975